

KANSAS

Stafford


FORM 51 5M 2-38 TPCO.



Section 13 Township 24 Range 11W

Well No. #3 ~~Johnson~~ O'Haver

Company E. H. Moore

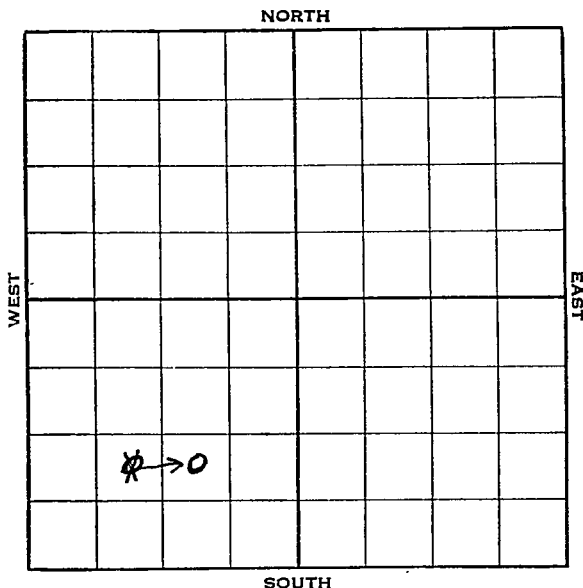

Stafford KANSAS

Map No. 47 Sec. 13 Twp. 24 R. 11WWell No. 3 JohnsonE. H. Moore

Company

Contractor

FIRST REPORT

NE SW SW

 Ft. from N. Line990 Ft. from S. Line Ft. from E. Line990 Ft. from W. Line

SECTION PLAT

0			

Location XRig up

Drilling and Remarks:

RECORD

Cased in., ft.Sand Gas Oil Total Depth

PRODUCTION

1st 24 hrs. Nat. 1st 24 hrs. after shot Gas Cu. Ft.Dry Hole Abandoned

Date

AUG 3 - 1938

19

H. D. Hatfield Scout

STAFFORD KANSAS

Map No. 47 Sec. 13 Twp. 24 R. 11 WWell No. 3-JohnsonE. H. Moore Company

Contractor

NW SE SW CORRECTION

SECTION PLAT

 Ft. from N. Line940 Ft. from S. Line990 Ft. from E. Line Ft. from W. Line

CORRECTION

Location Rig up

Drilling and Remarks:

LOC. First Reported

As NE SW SW but

moved to

NW SE SW

RECORD

Cased in., ft.Sand Gas Oil Total Depth

PRODUCTION

1st 24-hrs. Nat. 1st 24 hrs. after shot Gas Cu. Ft.Dry Hole Abandoned

Date

AUG 17 1932

H. D. Hatfield

19

Scout


KANSAS

Map No. 47 Sec. 13 Twp. 24 R. 11Well No. 3-O'HaverE H Moore Inc Company

Contractor

CORRECTION

SECTION PLAT

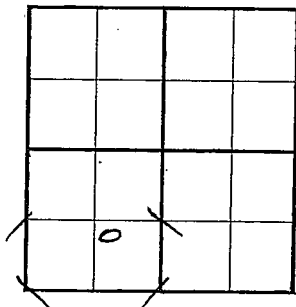

_____ Ft. from N. Line

990 Ft. from S. Line990 Ft. from E. Line

_____ Ft. from W. Line

CORRECTION

Location _____

RECORD

Cased _____ in., _____ ft.

Sand _____

Gas _____

Oil _____

Total Depth _____

PRODUCTION

1st 24 hrs. Nat. _____

1st 24 hrs. after shot _____

Gas _____ Cu. Ft.

Dry Hole _____

Abandoned _____

Date

AUG 31 1938

19

E. D. Hatfield

Scout

Map No. 47 Sec. 13 Twp. 24 R. 11WWell No. 3 O'HaverE. H. Moore

Company

Contractor

COMPLETED

NW SE SW

1 Ft. from N. Line990 Ft. from S. Line990 Ft. from E. Line Ft. from W. Line

SECTION PLAT

	0		

Location Rig up

Drilling and Remarks:

RECORD

Cased 7 in., 3788 ft.Sand Misener 3788Gas Oil Total Depth 3808

PRODUCTION

1st 24 hrs. Nat. 1st 24 hrs. after shot Gas Cu. Ft.Dry Hole Abandoned

Date

SEP 14 1938 19H. D. Hatfield

Scout

POT 3150
Flow