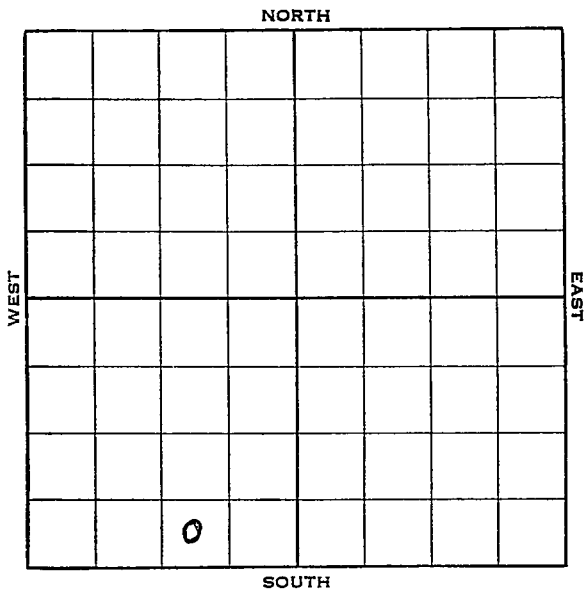


KANSAS

stafford

FORM 51 5M 2-38 TPCO.

Section 13 Township 24 Range 11-WWell No. #7 O'HaverCompany E. H. Moore, Inc.

Stafford **KANSAS**Map No. _____ Sec. 13 Twp. 24 R. 11WWell No. 7 O'HaverE. H. Moore, Inc. Company

Contractor

FIRST REPORT**SW SE SW**

_____ Ft. from N. Line

330 Ft. from S. Line990 Ft. from E. Line

_____ Ft. from W. Line

SECTION PLAT

Location _____

Rig up _____

Drilling and Remarks:

RR**RECORD**

Cased _____ in., _____ ft.

Sand _____

Gas _____

Oil _____

Total Depth _____

PRODUCTION

1st 24 hrs. Nat. _____

1st 24 hrs. after shot _____

Gas _____ Cu. Ft.

Dry Hole _____

Abandoned _____

Date

OCT 19 1938**H. D. Hatfield**

19

Scout

Stafford KANSAS

Map No. 47 Sec. 13 Twp. 24 R. 11WWell No. 7 O'HaverE. H. Moore

Company

Contractor

COMPLETED

SW SE SW

 Ft. from N. Line330 Ft. from S. Line990 Ft. from E. Line Ft. from W. Line**SECTION PLAT**

	0		

Location Rig up

Drilling and Remarks:

POT 1662**RECORD**Cased 7 in., 3796 ft.Sand Misener 3796Gas Oil Total Depth 3820**PRODUCTION**1st 24 hrs. Nat. 1st 24 hrs. after shot Gas Cu. Ft.Dry Hole Abandoned

Date

NOV 22 1938

19

H. D. Hatfield

Scout