


Section 13 Township 24 Range 13W

Well No. #1 Hartnett

Company Phillips

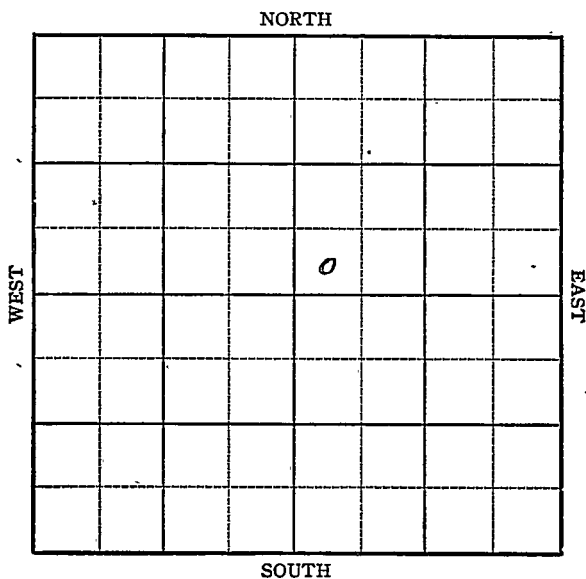

Sec. 13 Twp. 24 R. 13W

Well No. #1 Hartnett Farm

Phillips Company

Wildcat


 Ft. from N. Line

330 Ft. from S. Line

 Ft. from E. Line

330 Ft. from W. Line

elev. 1905

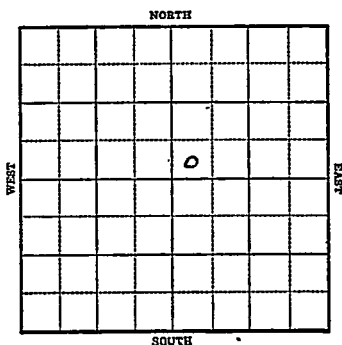

1944

R E P O R T

2/16 Location
2/23 8" @ 388
Drlg. 1420
3/1 Drlg. 3278
3/8 Lans 2530
Viola 3889
sd. 3928-30
Drilling 3996.
3/15 Viola 4007
Arb. 4085
TD 4115

*3889
1905
-1984*

ABANDONED

KANSAS


Map No. 83 Sec. 13 Twp. 24 R. 13WWell No. 1 HartnettPhillips Company

FIRST REPORT

Contractor

SW NE

SECTION PLAT

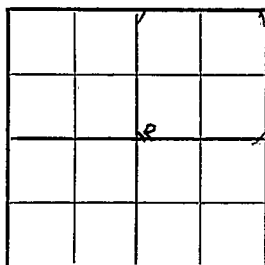 Ft. from N. Line330 Ft. from S. Line Ft. from E. Line330 Ft. from W. Line

Wildcat

Location XRig up

Drilling and Remarks:

RECORD

Cased in., ft.Sand Gas Oil Total Depth

PRODUCTION

1st 24 hrs. Nat. 1st 24 hrs. after shot Gas Cu. Ft.Dry Hole Abandoned

Date

FEB 16 1944

19

S. J. LEWIS Scout

KANSAS

Map No. 83 Sec. 13 Twp. 24 R. 13WWell No. 1 HartnettPhillips


Company

ABANDONED

Contractor

SW NE

SECTION PLAT

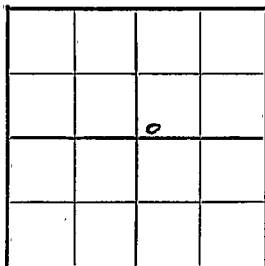 Ft. from N. Line330 Ft. from S. Line Ft. from E. Line330 Ft. from W. LineWildcatLocation Rig up

Drilling and Remarks:

*Vista 4007**CR 4085*

RECORD

Cased in., ft.Sand Gas Oil Total Depth 4115

PRODUCTION

1st 24 hrs. Nat. 1st 24 hrs. after shot Gas Cu. Ft.Dry Hole Abandoned

Date

MAR 15 1944 19

S. J. LEWIS Scout