


Section 13 Township 24 Range 11W

Well No. #1 L.M. Harrison

Company The Texas Co.

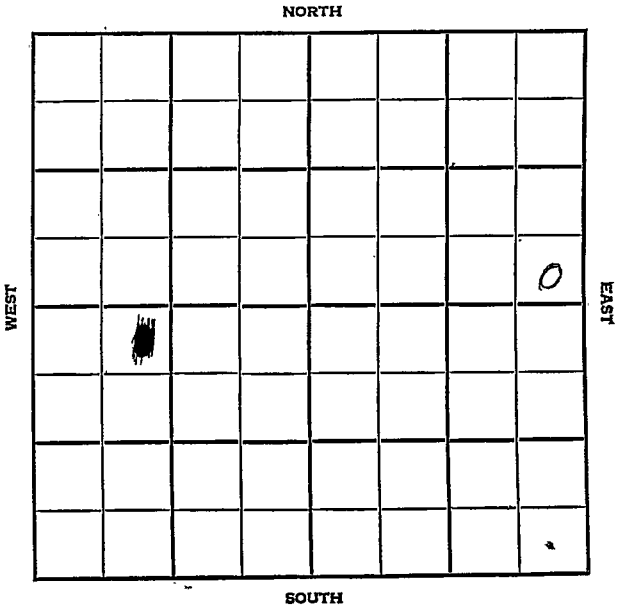

County Stafford Elev. _____
 Sec. 13 Twp. 24 Rgs. 14W
 Company The Texas Co.
 Farm Name L.M. Harrison No. 1

TOPS	DEPTH	LOG	DATUM	Loc. in Sec.
Anh.				SE SE NE
TP.				
H.				
Tr.				
Dg.				
Bl.				
L.				Geol. _____
K.C.				Contr. _____
B.K.C.				
Ce.				Stickle Drlg.
C.				
M.				Pool _____
M.				
K.				Rattlesnake SE
Mz.				
Ma.				
V.				
S.				
S.				
A.				
R.				
PE.				
G.				FIRST REPORT
T.D.				

OCT 17 1956
 0
 FIRST REPORT

Date Comm. spd. 10-9-56
10" @ 810 w/550, Drlg. 3255

REC'D VOM


10-21

[Handwritten signature]

Co.
 Lse.
 No.
 Sec.
 T.
 R.

County Stafford Elev. 1925
 Sec. 13 Twp. 24 Rge. 14W
 Company The Texas Co.
 Farm Name L.M. Harrison No. 1

TOPS	DEPTH	LOG	DATUM	Loc. in Sec.
Anh.				SE SE NE
Sp.				
H.	3433	3429		
Tr.	3451	3459		
Dp.	3470	3479		
Bl.				
L.	3596	3595		Geol.
K.C.				
B.K.C.				Contr.
Ce.	3909	3868		Stickle Drlg.
C.	3961	3936		
M.				Pool
M.				
K.		3959		Rattlesnake SE
Mz.				
Mo.				
V.	4056	4018		
S.	4135	4130		
S.				
A.		4182		ABANDONED
R.				
PC.				
G.				
TD.	4220			

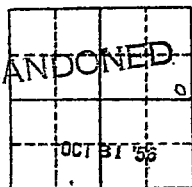

Date Comm. spd. 10-9-56

10" @ 810 w/550, Drlg. 3255 OCT 24 '55

DST 3658-76 1 hr. rec 50 V56 CM
 +110' SW FP 25-90 BIHP 1070
 120" DST 3904-22 1 hr. G/50"
 rec 90' GCM FP 70-70 BIHP
 1085/20 # 4032 OCT 31 '55

D&A