


Section 13 Township 24 Range 11W

Well No. 1 Harrison

Company Natural Gas & Oil

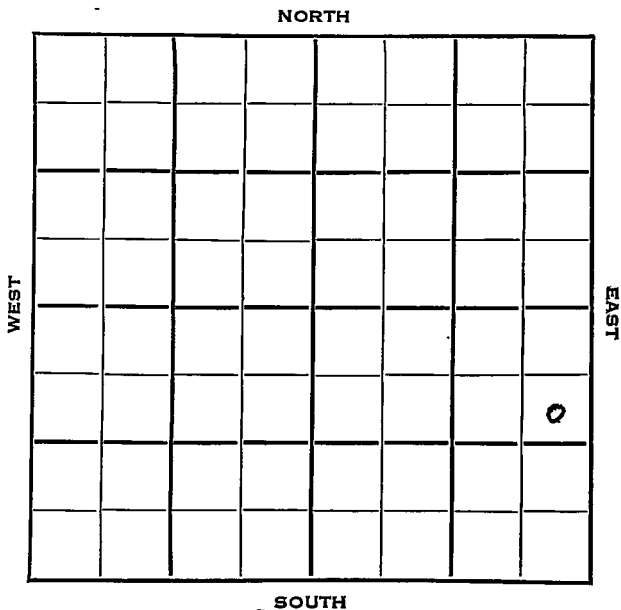

Stafford KANSAS

SEC. 13 TWP. 24 R. 14W ✓

WELL NO. 1 Harrison FARM

COMPANY Natural Gas & Oil

CONTRACTOR


Rattlesnake Pool

990 Ft. from N. Line

Ft. from S. Line

330 Ft. from E. Line

Ft. from W. Line

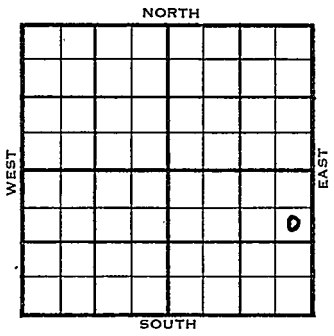

SE NE SE  
Shell Farmout

1954 ELEVATION 1934' REPORT

- 1/27 Spud 1-23-54  
8" @ 193  
Drlg. 2245'
- 2/3 Anhy 830', Heeb 3431', Br. L. 3564'  
Lans 3592'  
DST 3614'-47' 1-hr, 50' M, 900#  
DST 3652'-70' 1-hr, 420' oil, 1250#  
DST 3702'-41' 3/4 hr, 1 1/2 M gas 10' M 1230#  
DST 3746'-66' 1 hr, 175' gass oil  
1250#  
Drlg 3916'
- 2/10 B KC 3853', Cong 3909', Kh 3933', V.  
4002', Simp 4133', Arb 4200'  
DST 4201'-10',  
RTD 1 hr. 1455' Sulp Wtr. 1230#  
Schl  
5" @ 3880'

OVER

1954  
3/10

Spud 1-23-54  
Oil Well  
TD 4210'  
8" @ 193'  
Anhy 830', Heeb 3431', Br lime 3564',  
Lans 3592'  
DST 3614-47', opn 1 hr., rec. 420'  
oil, 1250#  
DST 3702-41', opn  $\frac{1}{4}$  hrs., rec.  $1\frac{1}{2}$   
mcfg, 10' mud, 1230#  
DST 3746-66', opn 1 hr., rec. 175'  
gassy oil, 1250#  
B KC 3853', Cong 3909', Kh 3933',  
Viola 4002', Simp. 4133', Arb. 4200'  
DST 4201-10', opn 1 hr., rec. 1455'  
sul wtr., 1230#  
5" @ 3880'  
CO to 3847', 12/3831 $\frac{1}{2}$ 35', 15 gsw  
2 goph 6 hrs.  
416,000 gas,  
PB 3790'  
12/3764-68, SS6  
30/3758-64, 2 gwph SSO 500A  
F 7 bo & ocwph  
F 39 bo 5 hrs.  
F 5 boph  
F 72 bo 15 hrs.  
F 88 bo 12 hrs.  
Comp. F 412 bopd

COMPLETED





Drlg. Data

F/ 7 bo &ocwph F/ .39 bo 5 hr.

F/ 5 boph F/ 72 bo 15 hr. F/ 88 bo

12 hr. Comp. F/ ~~412 bopd~~ --- -- --

Scout Cards
Land Small Map
Land Wall Map
Tracings
Frame Map
Force Map
Misc.

MAR 15 1954