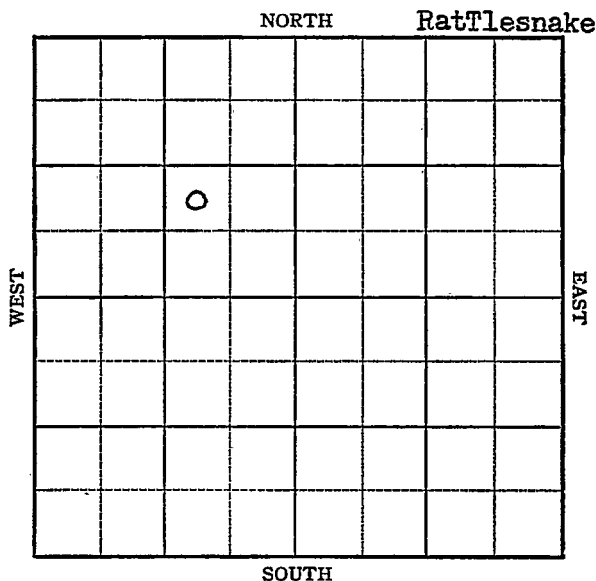


**KANSAS**

Stafford Co.

Section 13 Township 24 Range 11WWell No. #1 ShellCompany Atlantic & CSO

Stafford KANSAS ✓

Sec. 13 Twp. 24 R. 14W

Well No. #1 Shell Farm

Atlantic & CSO


Rattlesnake Pool (Lohman & Johnson, Cont.) Company

           Ft. from N. Line

990' Ft. from S. Line

990' Ft. from E. Line

           Ft. from W. Line

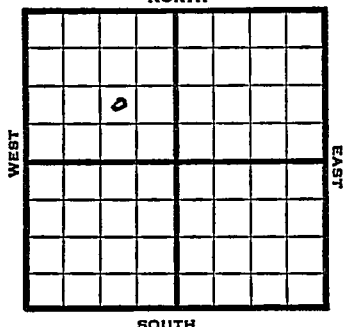

NW SE NW

1949

Elev 1920'

R E P O R T

8/17

Location

8/24

8" @ 827'

Drlg. 1720'

8/31

Drlg 3466'

9/7

Lansing 3591'

Drlg. 3663'

9/14

TD 3663'

9/21

TD 3685'

Lans 3591'

Aband.

**ABANDONED**

Kansas

Map No. \_\_\_\_\_ Sec. 13 Twp. 24 R. 14WWell No. 1 Shell

\_\_\_\_\_ Atlantic &amp; GSO \_\_\_\_\_ Company

\_\_\_\_\_ Lohman &amp; Johnson \_\_\_\_\_ Contractor

NW SE NW

FIRST REPORT  
SECTION PLAT

\_\_\_\_\_ Ft. from N. Line

990 Ft. from S. Line990 Ft. from E. Line

\_\_\_\_\_ Ft. from W. Line

|  |   |  |  |
|--|---|--|--|
|  |   |  |  |
|  | o |  |  |
|  |   |  |  |
|  |   |  |  |

Stafford County

Location x

Rig up \_\_\_\_\_

Drilling and Remarks:

## RECORD

Cased \_\_\_\_\_ in. \_\_\_\_\_ ft.

Sand \_\_\_\_\_

Gas \_\_\_\_\_

Oil \_\_\_\_\_

Total Depth \_\_\_\_\_

## PRODUCTION

1st 24 hrs. Nat. \_\_\_\_\_

1st 24 hrs. after shot \_\_\_\_\_

Gas \_\_\_\_\_ Cu. Ft.

Dry Hole \_\_\_\_\_

Abandoned \_\_\_\_\_

Date

AUG 17 1949 19S. J. LEWIS Scout

Map No. K83 Sec. 13 Twp. 24 R. 14W

Well No. 1 Shell

Atlantic & CSO Company

**ABANDONED**

Contractor

NW SE NW

*E. 1. 1920*  
**SECTION PLAT**

|  |   |  |  |
|--|---|--|--|
|  |   |  |  |
|  | 0 |  |  |
|  |   |  |  |
|  |   |  |  |
|  |   |  |  |

     Ft. from N. Line

990 Ft. from S. Line

990 Ft. from E. Line

     Ft. from W. Line

Stafford County

**RECORD**

Location                     

Cased            in.,            ft.

Rig up                     

Sand                     

Drilling and Remarks:

Gas                     

*None. 3591*

Oil                     

Total Depth 3685

**PRODUCTION**

1st 24 hrs. Nat.                     

1st 24 hrs. after shot                     

Gas                      Cu. Ft.

Dry Hole                     

Abandoned                     

Date

SEP 21 1949 19

S. J. LEWIS Scout