


Section 13 Township 24 Range 14W

Well No. #2 Shell

Company Atlantic & Cities Service

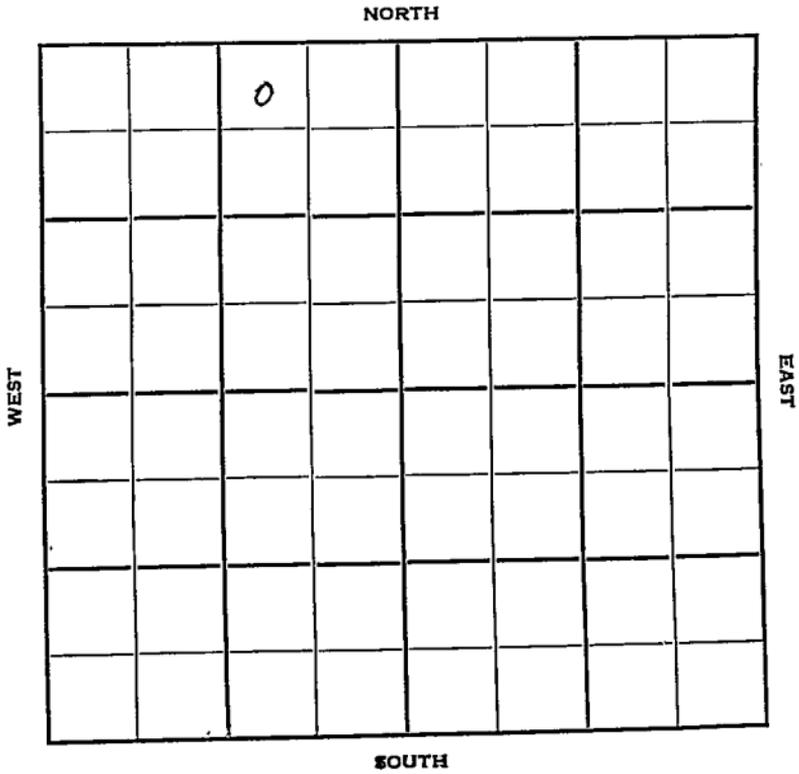

Sec. 13 Twp. 24 R. 14W ✓

Well No. #2 Shell Farm

Atlantic & Cities Service Company

Contractor

Rattlesnake


330' Ft. from N. Line

Ft. from S. Line

990' Ft. from E. Line

Ft. from W. Line

NW NE NW

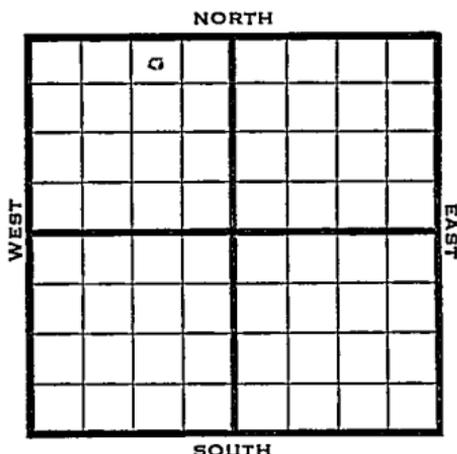

1950 Elev 1918' REPORT

3/15 8" @ 908'
Drlg. 1790'

4/19 TD 3845'
8" @ 908'
Heeb 3419'
Lans 3580'
DST 3648-59
Rec 1440' oil
TD 3845'
5" @ 3844'
72/3652-61
Comp 80 bopd
16% wtr.
Comp

COMPLETED

20883

Map No. _____ Sec. 13 Twp. 24 R. 14WWell No. 2 ShellAtlantic & Cities Service Company

Contractor

NW NE NW

330 Ft. from N. Line

_____ Ft. from S. Line

990 Ft. from E. Line

_____ Ft. from W. Line

Stafford County

SECTION PLAT

| | | | |
|---------------------|---|--|--|
| | 0 | | |
| | | | |
| FIRST REPORT | | | |
| | | | |
| | | | |

Location _____

Rig up _____

Drilling and Remarks:

8" @ 908

drlg. 1790

RECORD

Cased _____ in., _____ ft.

Sand _____

Gas _____

Oil _____

Total Depth _____

PRODUCTION

1st 24 hrs. Nat. _____

1st 24 hrs. after shot _____

Gas _____ Cu. Ft.

Dry Hole _____

Abandoned _____

Date

MAR 15 1950 19

J. E. TYRA Scout

Kansas

Map No. _____ Sec. 13 Twp. 24 R. 14WWell No. 2 Shell

Atlantic & Cities Service Company

Contractor

NW NE NW

E. 1. 1918

SECTION PLAT

330 Ft. from N. Line

| | | | |
|--|----------|--|--|
| | 0 | | |
| | | | |
| | COMPLETE | | |
| | | | |
| | | | |

_____ Ft. from S. Line

990 Ft. from E. Line

_____ Ft. from W. Line

Stafford County

Location _____

Rig up _____

Drilling and Remarks:

8" @ 908Neel. 3419Leas. 3580DST 3648-59Rec. 1440' oilT.D. 38455" @ 3844

RECORD

Cased _____ in., _____ ft.

Sand _____

Gas _____

Oil _____

Total Depth 3845

PRODUCTION

1st 24 hrs. Nat. _____

1st 24 hrs. after shot _____

Gas _____ Cu. Ft.

Dry Hole _____

Abandoned _____

Date

APR 19 1950 19J. E. TYRA Scout

