

Sec. 13 Twp. 24 R. 14-W ✓

Well No. #2 Wise Farm

Atlantic & GSO Company


Rattlesnake Pool

990 Ft. from N. Line

_____ Ft. from S. Line

_____ Ft. from E. Line

990 Ft. from W. Line

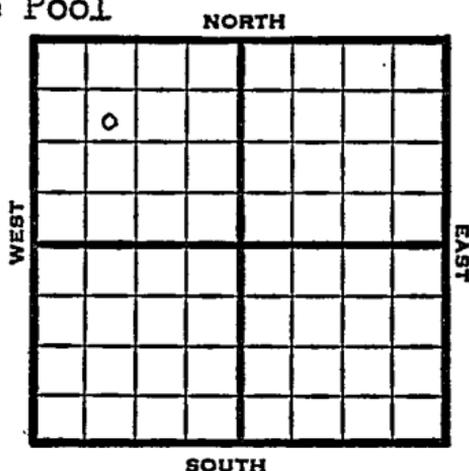

SE NW NW

1949	Elev 1923'	REPORT
1/26		Location
2/2		"
2/9		RUR
2/16		8" @ 835' Drlg. 1975'
2/23		Lansing 3584' Drlg. 3660'
3/2		Drlg. 3871'
3/8		Simpson sd 4148' Arb. 4181' TD 4205 5" @ 4203'
3/16		Plug 3741' 17 shots 3650-58 2650' oil
3/23		1000 acid Swb 46 bbls oil PH 6 hrs.
3/30		"
4/6		TD 4205' Lans. 3584' Arb. 4181' 5" @ 4203' Perf Lans. 2000 acid Bom & Pot 1450 Oil 390 Gr. Comp

COMPLETED OVER

1951

8/15

OilWell TD 3752
KC 3584 Simp 4129
Arb. 4181 OTD 4205
5" @ 4203 30/3708-13 500 A
S/113 bw 30 bo 16 hr. PB 3752
1000 A 1,000,000 Gas
30 3741-46 500 A
S/1/4 bfph 10% oil
Comp. 39 Bopd 10 bw

Q.W.W.O.

FIRST REPORT
R
COMPLETED

Map No. _____ Sec. 13 Twp. 24 R. 14W

Well No. 2 Wise

Atlantic & CSO Company

FIRST REPORT Contractor

SE NW NW


SECTION PLAT

990 Ft. from N. Line

_____ Ft. from S. Line

_____ Ft. from E. Line

990 Ft. from W. Line

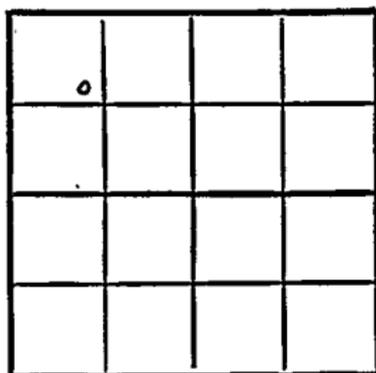

Stafford County

Location X

Rig up _____

Drilling and Remarks:

RECORD

Cased _____ in., _____ ft.

Sand _____

Gas _____

Oil _____

Total Depth _____

PRODUCTION

1st 24 hrs. Nat. _____

1st 24 hrs. after shot _____

Gas _____ Cu. Ft.

Dry Hole _____

Abandoned _____

Date

JAN 26 1949 19

S. J. LEWIS Scout

County **Stafford** State **Kansas**

Sec. **13** (Blk. Twp.) **24** (Sur. Rge.) **14W** Map No.

Operator **Atlantic & CSO**

Well No. **2** Farm **Wise**

Elev. **1923** Location **SE NW NW**

990 Ft. From **N** Line **NW**

990 Ft. From **W** Line **Quarter**

1st. Report **AUG 15 1951**

Completion **AUG 15 1951**

Remarks **OWWO**

Spudding Date

Drig. Data **Oil well TD 3752 Rattlesnake Pool**

KC 3584 Simp. 4129 Arb. 4181 OTD 4205

5" @ 4203 30/ 3708-13 500 A S/ 113 bw

30 bo 16 hr. PB 3752 1000 A

1,000,000 gas 30. 3741-46 500 A

S/ 1/4 bfph 10% oil Comp. 39 bopd 10 bw

J. E. TYRA