


SECTION 13 TOWNSHIP 24 RANGE 32W

WELL NO. #1 Russell GU "G"

COMPANY Pan American Petr. Corp.

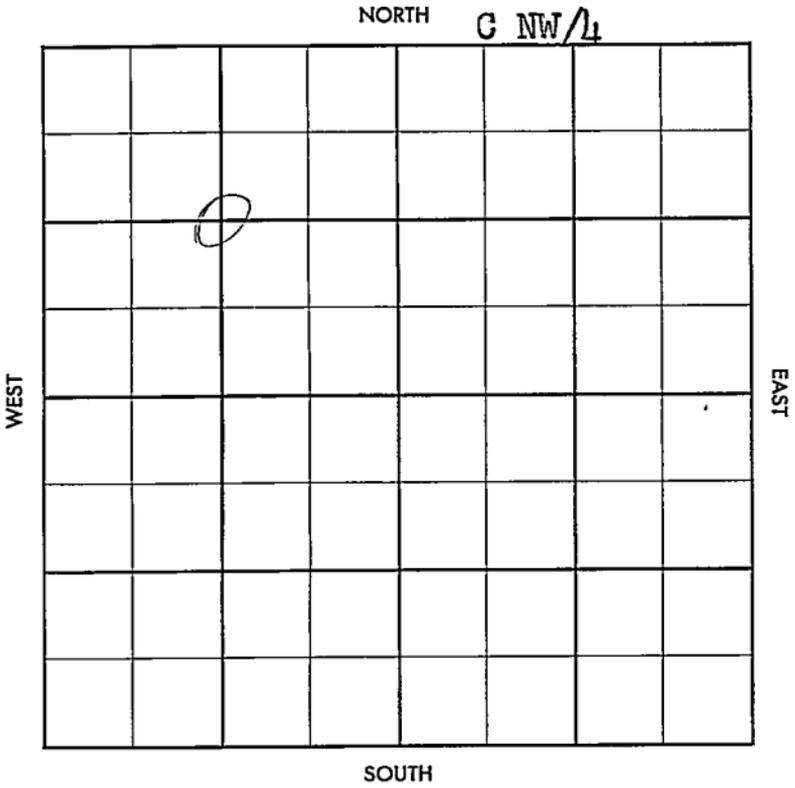

County Finney Elev. 2907 RB

Sec. 13 Twp. 24 Rge. 32W

Company Pan American Pet. Corp.

FarmName Russell GU "G" No. 1

Co.

Use.

No.

Sec.

T.

R.

TOPS	DEPTH	LOG	DATUM
Anh.			
Tp.			
H.			
Tr.			
Dg.			
Bl.			
L.			
K.C.			
B.K.C.			
Ce.			
C.			
M.			
M.			
K.			
Mz.			
Me.			
V.			
S.			
S.			
A.			
R.			
Pe.			
G.			
T.D.			

Loc. in Sec.

G NW/4

Geol.

Contr.

Noble Drlg.

Pool

FIRST REPORT

FEB 20 '57

Date Comm. 2-15-57


8" @ 1085/650 Drlg. 1400

351

County Finney Elev. 2907 RB
 Sec. 13 Twp. 24 Rge. 32W
 Company Pan American Pet. Corp.
 Farm Name Russell GU "G" No. 1

TOPS	DEPTH	LOG	DATUM
Anh. <u>Herr</u>		<u>2613</u>	
Tr. <u>K 1/2</u>		<u>2644</u>	
H.			
Tr.			
Dg.			
Bl.			
L.			
K.C.			
B.K.C.			
Ce.			
C.			
M.			
M.			
K.			
Mz.			
Ma.			
V.			
S.			
S.			
A.			
R.			
PE.			
G.			
TD.	<u>2655</u>		

Loc. in Sec. C NW/4
 Geol. _____
 Contr. Noble Drlg.
 Pool _____

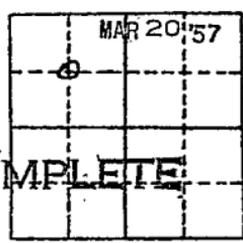

Date Comm. 2-15-57
8" @ 1085/650 Drlg. 1400 FF 27 57
5/2 2649/1000 MAR 6 57 CO. 2655
N.S. PP 2641 80/2622-32 Fiac
10x10 9a 5,367 MCFG + 8 1/2 WFL
SIP MAR 13 57
72-20 11,766 mcfg
SIP 403*

Co.
 Lse.
 No.
 Ser.
 T.
 R.