

KANSAS Rinney


FORM 51 5M 4-41 PETROL

Section 13 Township 24 Range 34-W

Well No. #1 Layman

Company Kansas Nebraska Pipe Line

Wildcat

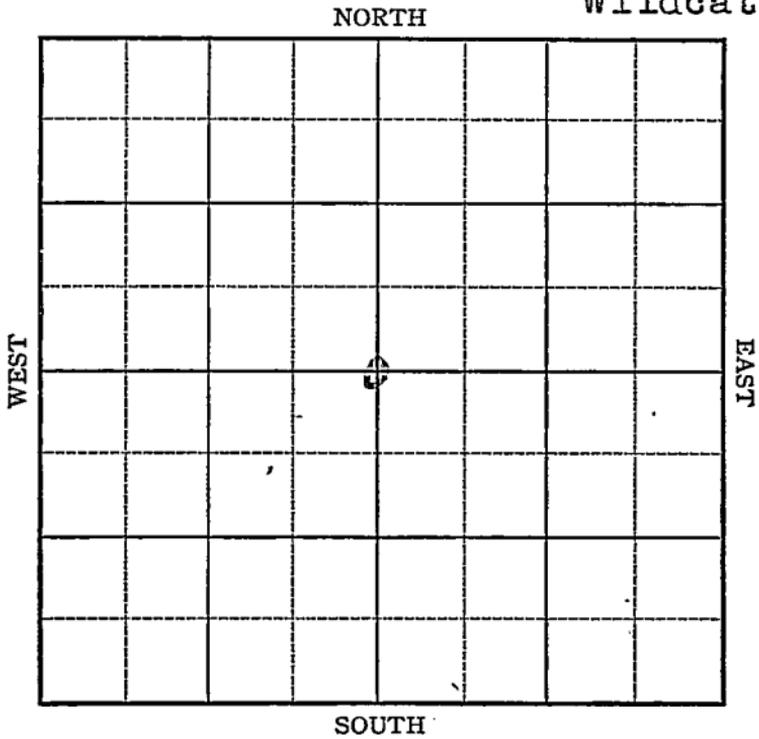

Sec. 13 Twp. 24 R. 34-W

Well No. #1 Layman Farm

Kansas Nebraska Pipe Line Company


(Wildcat)

2640 Ft. from N. Line

_____ Ft. from S. Line

2640 Ft. from E. Line

_____ Ft. from W. Line

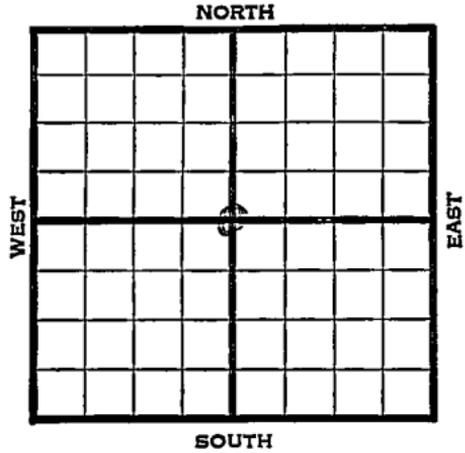

Elw. 2906

1942

REPORT

5/20

Location

5/27

"

6/3

Rotary.

6/10

Drlg. 2350'

6/17

7" - 2522-25' T.D. RUST.

6/24

Drlg. 2650' 1-3/4 M gas.

7/1

" " "

7/8

T.D. 2733' 1.6 M gas.

7/15

" " "

7/22

" " "

7/29

" " "

8/5

" " "

8/12

" " "

8/19

Winefield 2560 Herrington 2503

T.D. 2733

7" - 2522

1.9 M. Gas.

COMPLETED

Finney

Map No. MM Sec. 13 Twp. 24 R. 34W

Well No. 1 Layman


Kansas Nebraska Pipe Line Company

FIRST REPORT Contractor

C SE/C

SECTION PLAT

2640 Ft. from N. Line

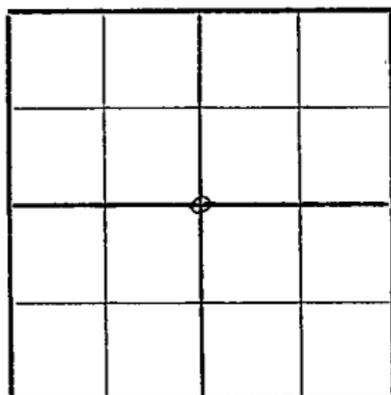

_____ Ft. from S. Line

2640 Ft. from E. Line

_____ Ft. from W. Line

WILDCAT

Location XXX

RECORD

Rig up _____

Cased _____ in., _____ ft.

Drilling and Remarks:

Sand _____

Gas _____

Oil _____

Total Depth _____

PRODUCTION

1st 24 hrs. Nat. _____

1st 24 hrs. after shot _____

Gas _____ Cu. Ft.

Dry Hole _____

Abandoned _____

Date

MAY 20 1942

19

S. J. LEWIS

Scout

Finney

Map No. MM Sec. 13 Twp. 24 R. 34WWell No. 1 LaymanKansas Nebraska Pipe CompanyCOMPLETED Contractor

C SE C


SECTION PLAT

2640 Ft. from N. Line

_____ Ft. from S. Line

2640 Ft. from E. Line

_____ Ft. from W. Line

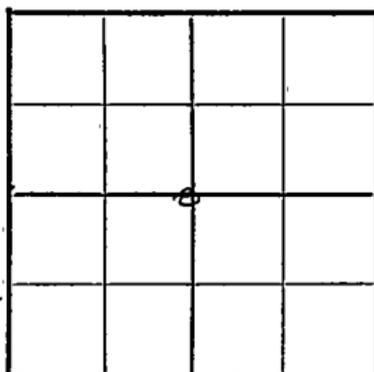

WILD CAT

Location _____

Rig up _____

Drilling and Remarks:

*Wong 1662560**Herrington 2523**7" @ 2522**1.9 M Gas*

RECORD

Cased _____ in., _____ ft.

Sand _____

Gas _____

Oil MM _____Total Depth 2733 _____

PRODUCTION

1st 24 hrs. Nat. _____

1st 24 hrs. after shot _____

Gas _____ Cu. Ft.

Dry Hole _____

Abandoned _____

Date ' _____

AUG 19 1942 19S. J. LEWIS Scout