


Section 14 Township 24 Range 11-W

Well No. 5 Krey

Company Pure

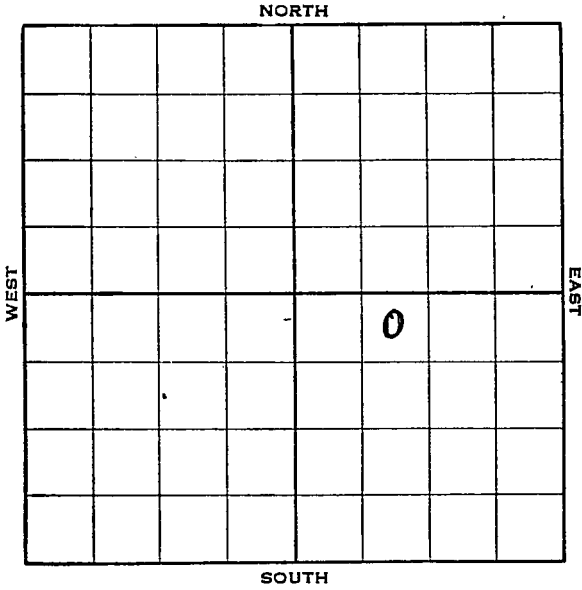

Sec. 14 Twp. 24 R. 11-W

Well No. #5 Krey Farm

Pure Company


330 Ft. from N. Line

_____ Ft. from S. Line

_____ Ft. from E. Line

990 Ft. from W. Line

Elev. 1818'

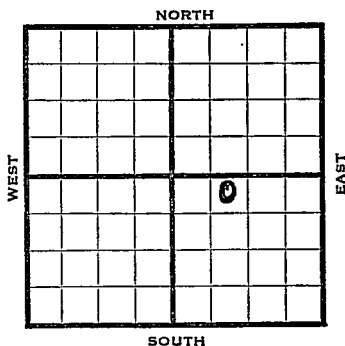

1938	REPORT
6/8	B.R.R.
6/17	10" @ 270'. WOC.
6/24	Dr̄lg. 2115'.
7/1	Dr̄lg. 3350'
7/8	Lans. 3402'.
	Base Kinderhook 3790'.
	T. D. 3791'. 7" - 3790½'.
7/15	Misner 3794'. 1000' oil @ 3797'
	T. D. 3816'. Trace wtr. C. O.
7/22	T. D. 3718'. Flowed 257 oil in
	1½ hrs. Shot 5 qts.
	Flowed 295 oil in 1½ hrs.
7/27	Misner 3794'.
	Viola 3817'.
	T. D. 3817'.
	Potential 1961 bbls., Flow.
	COMPLETED

Map No. 17 Sec. 14 Twp. 24 R. 11WWell No. 5 KreyPure

Company

Contractor

FIRST REPORT

NE NW SE

330 Ft. from N. Line

_____ Ft. from S. Line

_____ Ft. from E. Line

990 Ft. from W. Line**SECTION PLAT**

		o	

Location _____

Rig up _____

Drilling and Remarks:
BRR**RECORD**

Cased _____ in., _____ ft.

Sand _____

Gas _____

Oil _____

Total Depth _____

PRODUCTION

1st 24 hrs. Nat. _____

1st 24 hrs. after shot _____

Gas _____ Cu. Ft.

Dry Hole _____

Abandoned _____

Date

JUN 8 - 1938 19 H. D. Hatfield Scout

Stafford KANSAS

Map No. 47 Sec. 14 Twp. 24 R. 11WWell No. 5 KreyPure

Company _____

Contractor _____

COMPLETED

NE NW SE330 Ft. from N. Line

_____ Ft. from S. Line

_____ Ft. from E. Line

990 Ft. from W. Line

SECTION PLAT

		0	

Location _____

Rig up _____

Drilling and Remarks:

Pot 1961Flow

RECORD

Cased _____ in., _____ ft.

~~Sand~~ Misener 3794Gas (via 3817)

Oil _____

Total Depth 3817

PRODUCTION

1st 24 hrs. Nat. _____

1st 24 hrs. after shot _____

Gas _____ Cu. Ft.

Dry Hole _____

Abandoned _____

Date

Jul 27 1938

19

H. D. Hatfield

Scout