

KANSAS


Stafford

Form 51—5M—7-39—Palace


Section 14 Township 24 Range 11-W

Well No. #11 Emma Martin #10

Company Stanolind

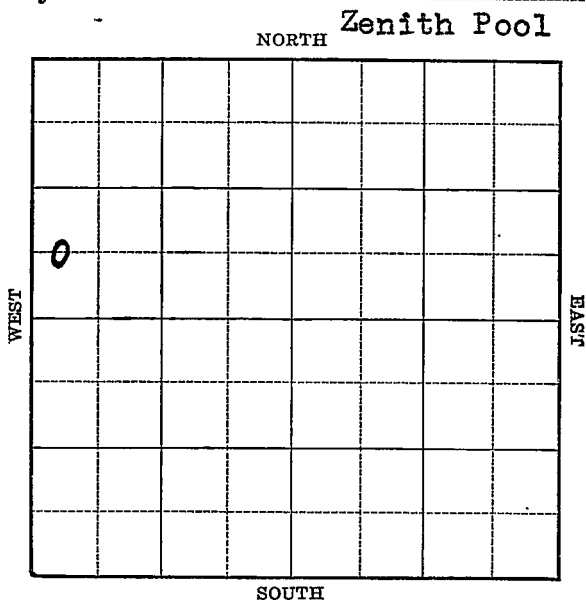

Company

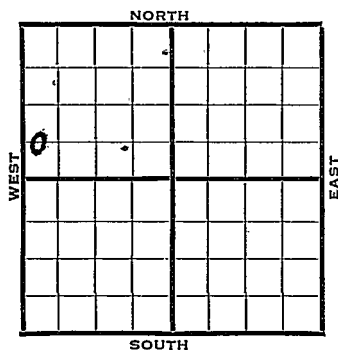

Elev. 1816

	REPORT
1940	
3/27	Location
4/4	"
4/12	"
4/18	10" - 256' WOC.
4/26	TD 3004'
5/2	Misener 3772-75' T.D.
	7" - 3774' WOC.
5/9	T.D. 3820' Swab 2 bbls. per hour.
5/16	Coring 3888'
5/23	T.D. 3893' P.B. to 3832'
	S.W. Viola 3801' 3000 acid.
	Flow 33 bbls. oil per hour 5 hours.
	OVER

1940

5/29

Misener 3772'

Viola 3801'

T.D. 3893'

P.B. to 3832'

3000 acid.

Bomb potential 833 bbls., 10%
water.

Maximum 2700 bbls.

COMPLETED

Map No. 47 Sec. 14 Twp. 24 R. 11WWell No. 11 Emma MartinStanolind

Company

FIRST REPORT

Contractor

C W L SW NW

Ft. from N. Line

660 Ft. from S. Line

Ft. from E. Line

330 Ft. from W. Line**ZENITH POOL****SECTION PLAT**

o			

Location X

Rig up

Drilling and Remarks:

RECORD

Cased _____ in., _____ ft.

Sand _____

Gas _____

Oil _____

Total Depth _____

PRODUCTION

1st 24 hrs. Nat. _____

1st 24 hrs. after shot _____

Gas _____ Cu. Ft.

Dry Hole _____

Abandoned _____

Date

MAR 27 1940 19S. J. LEWIS

Scout

Stafford **KANSAS**Map No. 47 Sec. 14 Twp. 24 R. 11WWell No. 10 Emma MartinStanolind

Company

CORRECTION

Contractor

SECTION PLATC W L SW NW Ft. from N. Line660 Ft. from S. Line Ft. from E. Line330 Ft. from W. LineZenith Pool

o			

Location Rig up

Drilling and Remarks:

Reported as #11**RECORD**Cased in., ft.Sand Gas Oil Total Depth **PRODUCTION**1st 24 hrs. Nat. 1st 24 hrs. after shot Gas Cu. Ft.Dry Hole Abandoned

Date

APR 3 1943 19 S. J. LEWIS Scout

Map No. 47 Sec. 14 Twp. 24 R. 11WWell No. 10 Emma MartinStanolind

Company

Contractor

COMPLETED

C W L SW NW

Ft. from N. Line

660

Ft. from S. Line

Ft. from E. Line

330

Ft. from W. Line

ZENITH POOL

SECTION PLAT

Location _____

Rig up _____

Drilling and Remarks:

*Muscle 3772**Viola 3801**P.O. 3832.**3000 acid**Born & Boy 3833**10 To W**Aluminum 2700*

RECORD

Cased _____ in., _____ ft.

Sand _____

Gas _____

Oil _____

Total Depth 3899

PRODUCTION

1st 24 hrs. Nat. _____

1st 24 hrs. after shot _____

Gas _____ Cu. Ft.

Dry Hole _____

Abandoned _____

Date

MAY 29 1940 19

S. J. LEWIS

Scout