

KANSAS


Stafford

FORM 51 5M 2-38 TPCO.

Section 14 Township 24 Range 11W


Well No. #7 Krey

Company Pure

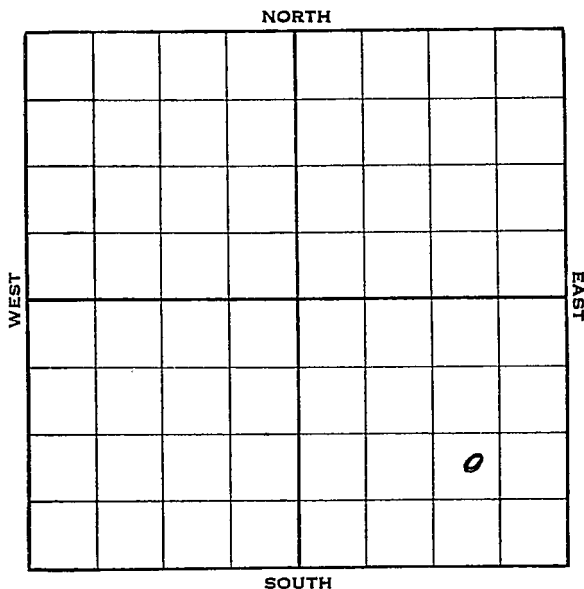

Sec. 14 Twp. 24 R. 11-WWell No. #7 Krey FarmPure Company Ft. from N. Line990 Ft. from S. Line990 Ft. from E. Line Ft. from W. Line

Elev. 1805

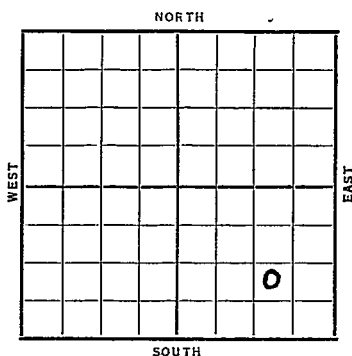

Date

REPORT

1938

8/3 Cellar.

8/12 R U R

8/19 10" - 264'. Dlg. 1950'.

8/26 Dlg. 3780'.

9/2 Lans. 3390'. Misner 3785'.

T. D. 3787'. 7" - 3786'. RUST.

9/9 dlg. plug.

9/16 T.D. 3812' C. O.

9/21 7" at 3786'.

Misner 3785'.

T. D. 3812'.

Potential 2023 bbls.

COMPLETED

Map No. 47 Sec. 14 Twp. 24 R. 11WWell No. 7 KreyPure

Company

Contractor

FIRST REPORT


NW SE SE

Ft. from N. Line

990 Ft. from S. Line990 Ft. from E. Line

Ft. from W. Line

SECTION PLAT

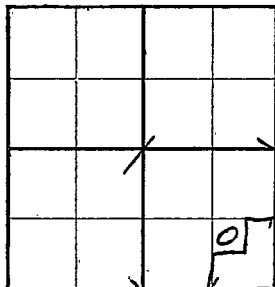

Location

Rig up

Drilling and Remarks:

Cellar

RECORD

Cased _____ in., _____ ft.

Sand _____

Gas _____

Oil _____

Total Depth _____

PRODUCTION

1st 24 hrs. Nat. _____

1st 24 hrs. after shot _____

Gas _____ Cu. Ft.

Dry Hole _____

Abandoned _____

Date

AUG 3 - 1938 19

H. D. Hatfield Scout

Stafford KANSAS

Map No. 47 Sec. 14 Twp. 24 R. 11WWell No. 7 KreyPure

Company

Contractor

SECTION PLAT

NW SE SE

Ft. from N. Line

990 Ft. from S. Line990 Ft. from E. Line

Ft. from W. Line

			0

Location

Rig up

Drilling and Remarks:

RECORD

Cased 7 in., 3786 ft.Sand Misener 3785

Gas

Oil

Total Depth 3812

PRODUCTION

1st 24 hrs. Nat.

1st 24 hrs. after shot

Gas Cu. Ft.

Dry Hole

Abandoned

Pot 2023

Date

SEP 21 1938

19

Hathfield
By: Paul

Scout