


Stafford KANSAS

Section 14 Township 24 Range 11-W

Well No. 9 Krey

Company Pure

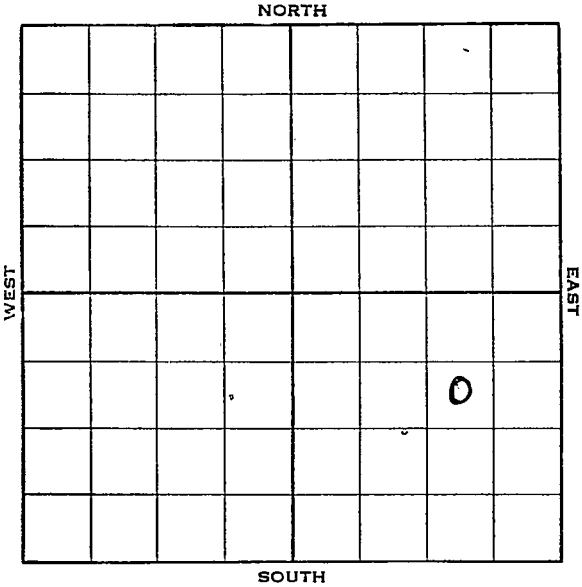

KANSAS

Stafford


Sec. 14 Twp. 24 R. 11-WWell No. #9 Krey FarmPure Company990 Ft. from N. Line

Ft. from S. Line

990 Ft. from E. Line

Ft. from W. Line

Elev. 1808

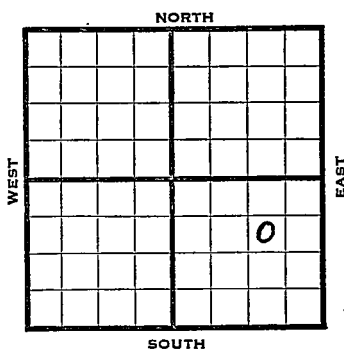

1933	REPORT
8/31	R U R
9/9	10" - 259'.. Dlg. - 2295'.
9/16	Lañs. 3400'. Dlg. 3477'.
9/23	Misener 3783'. 7" - 3784'.
	RUST.
9/30	" "
10/7	T. D. 3806' S.W. Will P. B.
10/14	P. B. 3802'.
	Shot 5 qts. 3794-3802'.
10/19	7" - 3784'..
	Misener 3783'.
	T. D. 3806'.
	P. B. to 3802'.
	Shot 5 qts. 3794-3802'.
	Flow 154½ bbls. 4 hrs.
	Potential 927 bbls.
	COMPLETED

Stafford KANSAS

Map No. 47 Sec. 14 Twp. 24 R. 11WWell No. 9 KreyPure

Company

Contractor

FIRST REPORT

990 SW NE SE
Ft. from N. Line

Ft. from S. Line

990 Ft. from E. Line

Ft. from W. Line

SECTION PLAT

			0

Location

Rig up

Drilling and Remarks:

RUR

RECORD

Cased _____ in., _____ ft.

Sand _____

Gas _____

Oil _____

Total Depth _____

PRODUCTION

1st 24 hrs. Nat. _____

1st 24 hrs. after shot _____

Gas _____ Cu. Ft.

Dry Hole _____

Abandoned _____

Date

AUG 31 1938

19

H. D. Hatfield Scout

Map No. _____ Sec. 14 Twp. 24 R. 11WWell No. 9 Krey

Pure _____ Company

Contractor _____

COMPLETED

SECTION PLAT

SW NE SE

990 Ft. from N. Line

_____ Ft. from S. Line

990 Ft. from E. Line

_____ Ft. from W. Line

			0

Location _____

Rig up _____

Drilling and Remarks:

Shot 5 gts
3794-3802

Flow $154 \frac{1}{4}$

POT 927

RECORD

Cased 7 in., 3784 ft.Sand Misener 3782

Gas _____

Oil _____

Total Depth 3806

PRODUCTION

1st 24 hrs. Nat. _____

1st 24 hrs. after shot _____

Gas _____ Cu. Ft.

Dry Hole _____

Abandoned _____

Date

OCT 10 1926H. D. Hatfield Scout