


Stafford

KANSAS

Section 14 Township 24 Range 11-W

Well No. 12-Krey

Company Pure

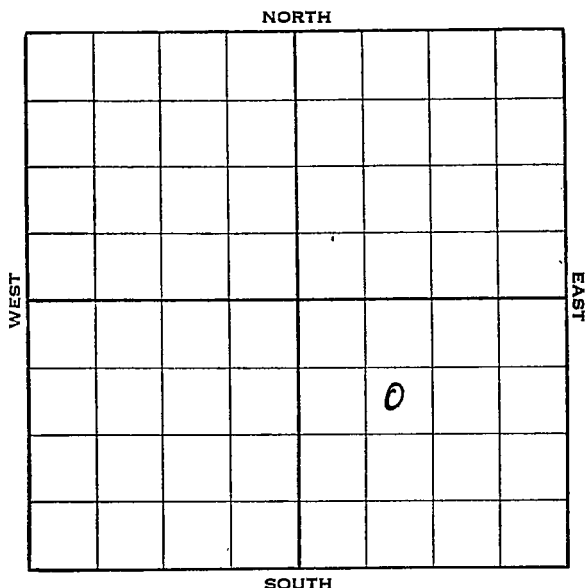

Stafford **KANSAS**Map No. _____ Sec. **14** Twp. **24** R. **11W**Well No. **12 - Krey****Pure**

Company _____

Contractor _____

FIRST REPORT**SE NW SE****990** Ft. from N. Line

_____ Ft. from S. Line

_____ Ft. from E. Line

990 Ft. from W. Line**SECTION PLAT**

		o	

Location **X**

Rig up _____

Drilling and Remarks:

RECORD

Cased _____ in., _____ ft.

Sand _____

Gas _____

Oil _____

Total Depth _____

PRODUCTION

1st 24 hrs. Nat. _____

1st 24 hrs. after shot _____

Gas _____ Cu. Ft.

Dry Hole _____

Abandoned _____

Date

OCT 12 1933

19

H. D. Hatfield

Scout

Stafford KANSAS

Map No. 47 Sec. 14 Twp. 24 R. 11WWell No. 12 KreyPure Company. Contractor

COMPLETED

SE NW SE

990 Ft. from N. Line Ft. from S. Line Ft. from E. Line990 Ft. from W. Line

SECTION PLAT

Location Rig up

Drilling and Remarks:

5 gts 3789-3805POT 402274 wtr

RECORD

Cased 7 in., 3787 ft.Sand Misener 3787Gas Oil Total Depth 3809

PRODUCTION

1st 24 hrs. Nat. 1st 24 hrs. after shot Gas Cu. Ft.Dry Hole Abandoned

Date

NOV 30 1938 19 M. D. Hatfield Scout