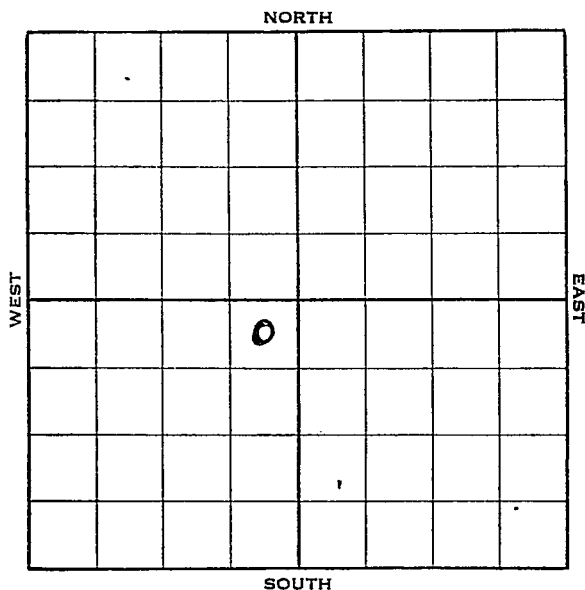


-Stafford


Section 14 Township 24 Range 11-WWell No. 2 Burt McCombCompany Stanolind

KANSAS

Stafford

Sec. 14 Twp. 24 R. 11-WWell No. #2 Burt McComb FarmStanolind Company330 Ft. from N. Line Ft. from S. Line330 Ft. from E. Line Ft. from W. Line

Elev. 1815

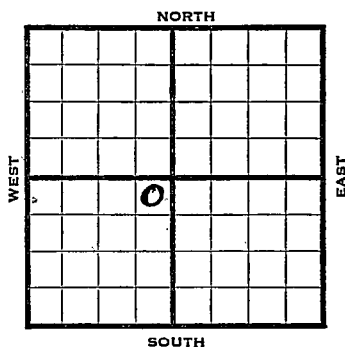

1938	REPORT
3/30	Location
4/8	10" @ 245'. WOC.
4/15	Drilg. 1800'.
4/22	Drilg. 3070'.
4/29	K.-G. 3400'.
	Base Kinderhook 3794 & 7".
	T.D. 3797'. RUST.
5/6	" " "
5/12	" " "
5/20	Coring 3798'.
5/27	Cored 3798-3808' no show.
	Cored 3808-11, rec 3' sat.
	sand. Misner 3809'.
	T.D. 3826'. Fishing.
6/3	Cleaning out.
6/10	T.D. 3828'. Shot 30 qts. 3809-21
	Cleaning out.
	OVER

1938

6/15 7" @ 3794'.

Misner 3809'.

T.D. 3828'.

Shot 30 qts.

Potential 1508 bbls., Flowing.

COMPLETED

Stafford KANSAS

Map No. 47 Sec. 14 Twp. 24 R. 11WWell No. 2 Burt McCombStanolind

Company

Contractor

FIRST REPORT

NE SW

330 Ft. from N. Line Ft. from S. Line330 Ft. from E. Line Ft. from W. Line

SECTION PLAT

	0		

Location XRig up

Drilling and Remarks:

RECORD

Cased in., ft.Sand Gas Oil Total Depth

PRODUCTION

1st 24 hrs. Nat. 1st 24 hrs. after shot Gas Cu. Ft.Dry Hole Abandoned

Date

MAR 30 1938₁₉H. D. Hatfield Scout

Stafford KANSAS

Map No. 47 Sec. 14 Twp. 24 R. 11WWell No. 2 Burt McCombStanolind

Company

Contractor

COMPLETED

NE SW

330 Ft. from N. Line Ft. from S. Line330 Ft. from E. Line Ft. from W. Line**SECTION PLAT**

	O		

Location Rig up

Drilling and Remarks:

*Shot 30 gts**POT 1508**Flowing***RECORD**Cased 7 in., 3794 ft.Sand Misener 3809Gas Oil Total Depth 3828**PRODUCTION**1st 24 hrs. Nat. 1st 24 hrs. after shot Gas Cu. FtDry Hole Abandoned

Date

JUN 15 1938 19H. D. Hatfield Scout