

# KANSAS

Form 51-5M-7-39-Palace


## Stafford

Section 14 Township 24 Range 11-W

Well No. #4 McComb

Company Stanolind

NORTH **Zenith Pool**

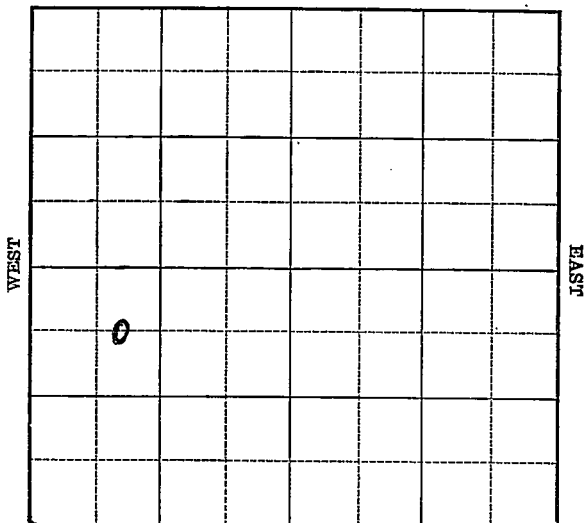

SOUTH

Sec. 14 Twp. 24 R. 11-W

Well No. #4 McComb Farm

Stanolind Company

(Zenith)


660 Ft. from N. Line

\_\_\_\_\_ Ft. from S. Line

\_\_\_\_\_ Ft. from E. Line

965 Ft. from W. Line

Elev. 1817

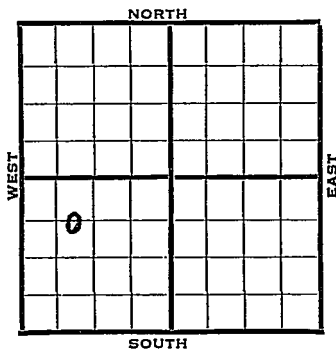

1940	REPORT
3/20	10" - 245'
	WOC at 247'
3/28	Drlg. 2752'
4/4	Drlg. 3671'
4/12	Misener 3810' Viola 3817' T.D. 7" - 3791'
4/18	3000 acid. Swab 30 bbls. per hour.
4/24	Misener 3810'
	Viola 3817'
	7" - 3791'
	T.D. 3832'
	3000 acid.
	Pump 299 oil plus 12% water.
	<b>COMPLETED</b>

Map No. 47 Sec. 14 Twp. 24 R. 11WWell No. 4 McCombStanolind

Company

Contractor

**FIRST REPORT****SECTION PLAT**660 **C E $\frac{1}{2}$  NW SW**  
Ft. from N. Line

Ft. from S. Line

Ft. from E. Line

965 Ft. from W. Line


**ZENITH POOL**

Location \_\_\_\_\_

Rig up \_\_\_\_\_

Drilling and Remarks:

**10" @ 245****WOC @ 247****RECORD**

Cased \_\_\_\_\_ in., \_\_\_\_\_ ft.

Sand \_\_\_\_\_

Gas \_\_\_\_\_

Oil \_\_\_\_\_

Total Depth \_\_\_\_\_

**PRODUCTION**

1st 24 hrs. Nat. \_\_\_\_\_

1st 24 hrs. after shot \_\_\_\_\_

Gas \_\_\_\_\_ Cu. Ft.

Dry Hole \_\_\_\_\_

Abandoned \_\_\_\_\_

Date

MAR 20 1940 19S. J. LEWIS

Scout

Map No. 47 Sec. 14 Twp. 24 R. 11W

Well No. 4 McComb

Stanolind Company

Contractor

**COMPLETED**

C  $E\frac{1}{2}$  NW SW

**SECTION PLAT**

660 Ft. from N. Line


\_\_\_\_\_ Ft. from S. Line

\_\_\_\_\_ Ft. from E. Line

965 Ft. from W. Line

ZENITH POOL

Location \_\_\_\_\_

**RECORD**

Rig up \_\_\_\_\_

Cased \_\_\_\_\_ in., \_\_\_\_\_ ft.

Drilling and Remarks:

Sand \_\_\_\_\_

*Mueser 3870*

Gas \_\_\_\_\_

*Viola 3817*

Oil \_\_\_\_\_

Total Depth 3832

*7" c 3791*

**PRODUCTION**

1st 24 hrs. Nat. \_\_\_\_\_

*3000 acid*

1st 24 hrs. after shot \_\_\_\_\_

*Pump. 299 oil (7+12%)*

Gas \_\_\_\_\_ Cu. Ft.

*Water*

Dry Hole \_\_\_\_\_

Abandoned \_\_\_\_\_

Date

APR 24 1940 19

S. J. LEWIS Scout