


Stafford

Section 14 Township 24 Range 11-W

Well No. 2 Mamie Volker "B"

Company Stanolind

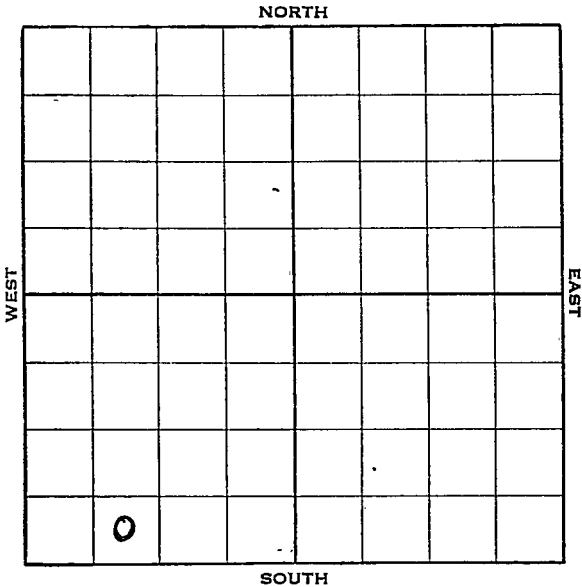

KANSAS

Stafford

Sec. 14 Twp. 24 R. 11-WWell No. #2 Mamie Volker "B" Farm
Stanolind Company

Ft. from N. Line

330


Ft. from S. Line

Ft. from E. Line

990

Ft. from W. Line

Elev. 1814

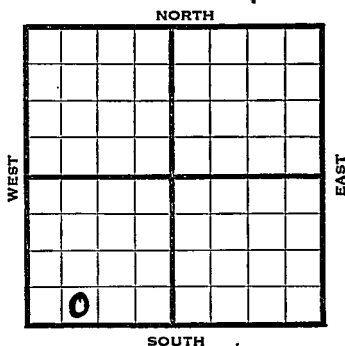

1938	REPORT
3/30	Location
4/8	R U R
4/15	13" @ 266'. Drlg. 1690'.
4/22	Drlg. 3005'.
4/29	K.C. 3412'.
	B. Kinderhook 3801'.
	Misner 3802', 7" @ 3799'.
	RUST.
5/6	T.D. 3809'. 1700' oil in 2 hrs.
5/12	Pay sand 3815'.
	Flowed 268 oil 3 hrs.
	Viola 3823'. T.D. 3827'. C. O.
5/20	" " " " " "
	" " " " " "
5/25	7" @ 3799'.
	Misner 3802'.
	T.D. 3827'.
	Potential 1716 bbls.
	Flowing thru 3" tubing.
	COMPLETED

Stafford

KANSAS

Map No. 47 Sec. 14 Twp. 24 R. 11WWell No. 2 Mamie Volker "B"

Stanolind

Company

Contractor

FIRST REPORT
SE SW SW Ft. from N. Line330 Ft. from S. Line Ft. from E. Line990 Ft. from W. Line

SECTION PLAT

O

Location XRig up

Drilling and Remarks:

RECORD

Cased in., ft.Sand Gas Oil Total Depth

PRODUCTION

1st 24 hrs. Nat. 1st 24 hrs. after shot Gas Cu. Ft.Dry Hole Abandoned

Date

MAR 30 1938

19

H. D. Hatfield

Scout

Stafford KANSAS

Map No. 47 Sec. 14 Twp. 24 R. 11WWell No. 2 Mamie Volker "B"Stanolind

Company

Contractor

COMPLETED

SE SW SW

Ft. from N. Line

330

Ft. from S. Line

Ft. from E. Line

990

Ft. from W. Line

SECTION PLAT

0			

Location

Rig up

Drilling and Remarks:

*POT. 1716**Flowing Thru
3" Tubing*

RECORD

Cased 7 in., 3799 ft.Sand Misener 3802

Gas

Oil

Total Depth 3827

PRODUCTION

1st 24 hrs. Nat.

1st 24 hrs. after shot

Gas Cu. Ft.

Dry Hole

Abandoned

Date

MAY 25 1900

19

H. D. Hatfield Scout