


KANSAS Stafford

Section 14 Township 24 Range 12-W

Well No. #3 O'Conner

Company Stanolind

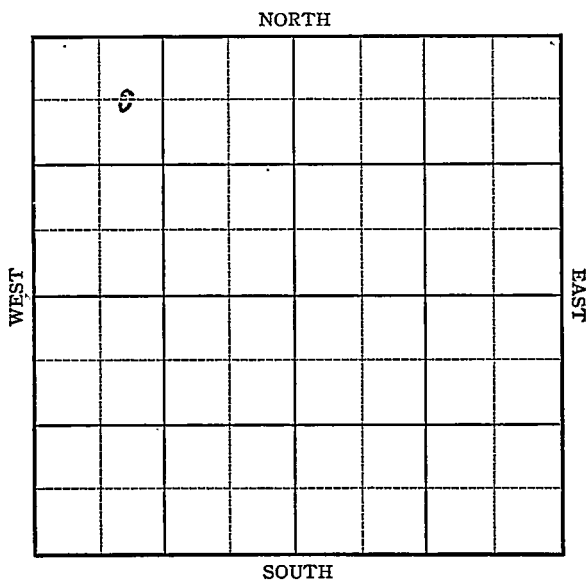

KANSAS

Stafford

Sec. 14 Twp. 24 R. 12-W

Well No. #3 O'Conner Farm

Stanolind Company

(Stafford)


660 Ft. from N. Line

_____ Ft. from S. Line

_____ Ft. from E. Line

990 Ft. from W. Line

Elev. 1870

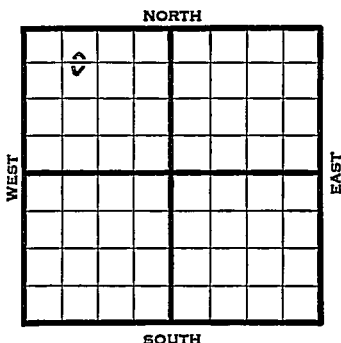

1941	REPORT
11/5	R.O.G.
11/13	8" - 255' WOC.
11/20	Anhy 642' Drlg. 2389'
11/28	Drlg. 3403'
12/10	Viola 3830'
	5" - 3830'
	T.D. 3842'
	3000 acid.
	Bomb potential 115,901 bbls.
	Maximum 3000 bbls.
	41. Gravity
	COMPLETED

Map No. 4-47 Sec. 14 Twp. 24 R. 12WWell No. 3 0' ConnerStanolind

Company

FIRST REPORT

Contractor

C EL NW NW

SECTION PLAT

660 Ft. from N. Line

_____ Ft. from S. Line

_____ Ft. from E. Line

990 Ft. from W. Line

STAFFORD POOL

Location _____

Rig up _____

Drilling and Remarks:

R. O. G.

RECORD

Cased _____ in., _____ ft.

Sand _____

Gas _____

Oil _____

Total Depth _____

PRODUCTION

1st 24 hrs. Nat. _____

1st 24 hrs. after shot _____

Gas _____ Cu. Ft.

Dry Hole _____

Abandoned _____

Date

NOV 5 1941 19S. J. LEWIS Scout

Map No. 47 Sec. 14 Twp. 24 R. 12W

Well No. 3 0' Conner

Stanolind Company

COMPLETED Contractor

C EL NW NW

SECTION PLAT

660 Ft. from N. Line

_____ Ft. from S. Line

_____ Ft. from E. Line

990 Ft. from W. Line

o			

STAFFORD POOL

Location _____

Rig up _____

Drilling and Remarks:

Viola 3838

5" @ 3838

3000 acid

Bony 1159018

Max 3000

H. J. G.

RECORD

Cased _____ in., _____ ft.

Sand _____

Gas _____

Oil _____

Total Depth 3842

PRODUCTION

1st 24 hrs. Nat. _____

1st 24 hrs. after shot _____

Gas _____ Cu. Ft.

Dry Hole _____

Abandoned _____

Date

DEC 1 0 1941 19

S. J. LEWIS Scout