


Section 14 Township 24 Range 12W

Well No. #2 Charles O'Connor

Company Stanolind.

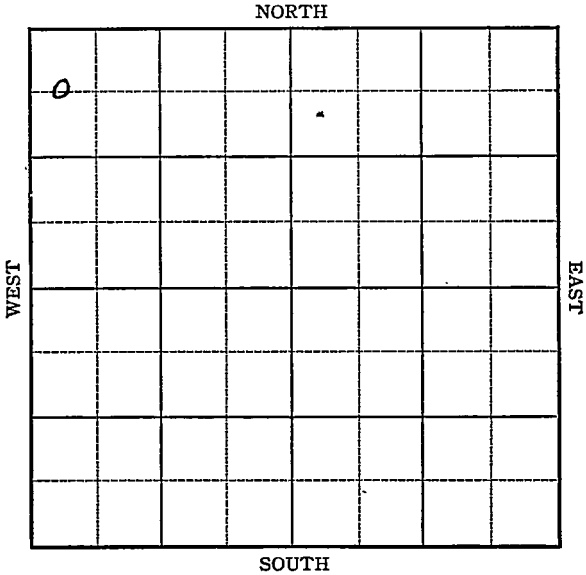

Sec. 14 Twp. 24 R. 12-W

Well No. #2 Charles O'Connor Farm

Stanolind Company

(Stafford)


660 Ft. from N. Line

_____ Ft. from S. Line

_____ Ft. from E. Line

330 Ft. from W. Line

Elev. 1872

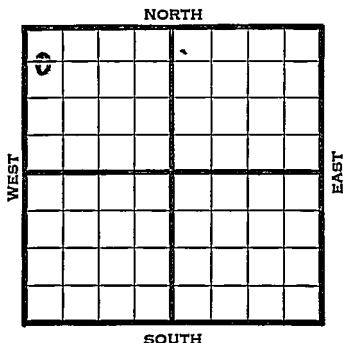

1941

REPORT

6/25 8" - 269' WOC 281'

7/3 Lost Circulation 2396' W.O.O.

7/10 Drlg. 3619'

7/17 Viola 3816' 5" - 3829'

T.D. 3831' RUST.

7/23 Viola 3816'

5" @ 3829

TD 3831'

3000 gals acid

Bomb potential 24638

Max 3000

42.6 Gravity

COMPLETED

Map No. 47 Sec. 14 Twp. 24 R. 12W

Well No. 2 Charles O'Connor

Stanolind Company

FIRST REPORT Contractor

C W L NW NW

SECTION PLAT

660 Ft. from N. Line

0			

_____ Ft. from S. Line

_____ Ft. from E. Line

330 Ft. from W. Line

STAFFORD POOL

Location _____

RECORD

Rig up _____

Cased _____ in., _____ ft.

Drilling and Remarks:

Sand _____

8 " - 269

Gas _____

WOC. 281

Oil _____

Total Depth _____

PRODUCTION

1st 24 hrs. Nat. _____

1st 24 hrs. after shot _____

Gas _____ Cu. Ft.

Dry Hole _____

Abandoned _____

Date

JUN 25 1941

S. J. LEWIS Scout

Map No. 47 Sec. 14 Twp. 24 R. 12WWell No. 2 Charles O'ConnorStanolind

Company

COMPLETED

Contractor

SECTION PLAT

C W L NW NW

660 Ft. from N. Line

_____ Ft. from S. Line

_____ Ft. from E. Line

330 Ft. from W. Line

0			

STAFFORD POOL

Location _____

Rig up _____

Drilling and Remarks:

*Vid 3816**5" @ 3829**3000 Oil**Born & 24638**Max 3000**42 6 Gr*

RECORD

Cased _____ in., _____ ft.

Sand _____

Gas _____

Oil _____

Total Depth 3831

PRODUCTION

1st 24 hrs. Nat. _____

1st 24 hrs. after shot _____

Gas _____ Cu. Ft.

Dry Hole _____

Abandoned _____

Date

JUL 23 1941 19S. J. LEWIS Scout