


Stafford County

Section 14 Township 24 Range 14W

Well No. #1 Mathews Estate

Company Lion Oil Ref.

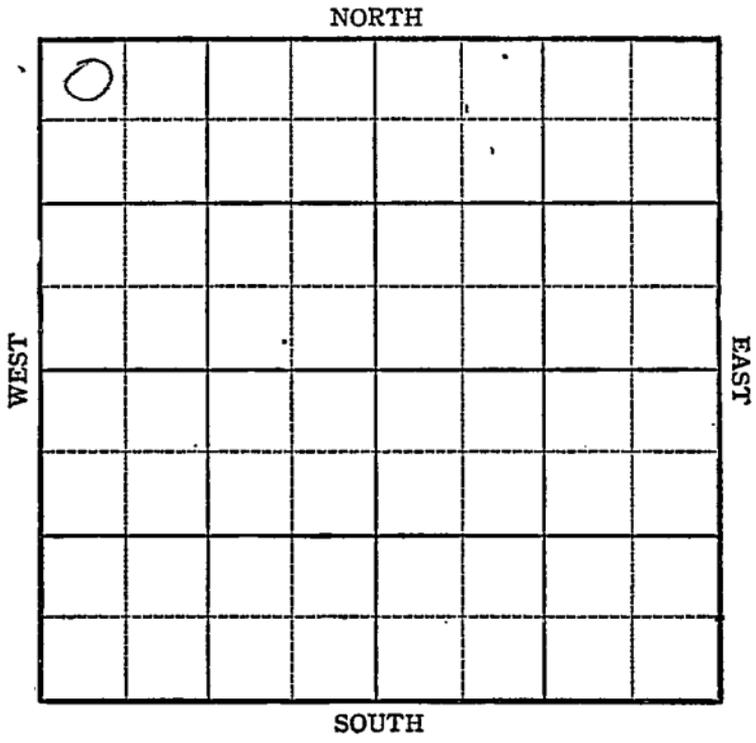

KANSAS

Stafford County

Sec. 14 Twp. 24 R. 14W

Well No. #1 Mathews Estate Farm

Lion Oil Ref. Company

Richland


330 Ft. from N. Line

_____ Ft. from S. Line

_____ Ft. from E. Line

330 Ft. from W. Line

NW/c Elev. 1942

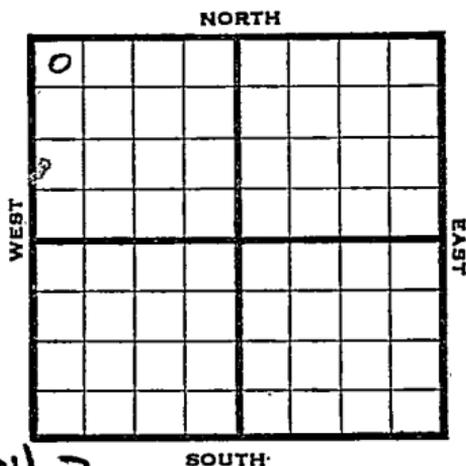

1944

R E P O R T

11/8 Location

11/16 8" @ 530' Drlg. 750'

11/24 Drlg. 2400

11/29 Drlg. 3560

12/6 Lans 3649
Drlg. 3948'

12/13 Viola 4022
Simp. 4192
Arb. 4222
TD 4280'

ABANDONED

Pool Name RichlandMap No. 83 Sec. 14 Twp. 24 R. 14WWell No. 1 Mathews estateLion Oil Ref. Company

FIRST REPORT Contractor

NW/c

SECTION PLAT

0			

330 Ft. from N. Line

Ft. from S. Line

Ft. from E. Line

330 Ft. from W. LineStaffordLocation X

Rig up _____

Drilling and Remarks:

RECORD

Cased _____ in., _____ ft.

Sand _____

Gas _____

Oil _____

Total Depth _____

PRODUCTION

1st 24 hrs. Nat. _____

1st 24 hrs. after shot _____

Gas _____ Cu. Ft.

Dry Hole _____

Abandoned _____

Date

NOV 8 1944

19

S. J. LEWIS Scout

Pool Name Richland

Map No. 83 Sec. 14 Twp. 24 R. 14W

Well No. 1 Mathews Estate

Lion Oil Ref. Company

ABANDONED

Contractor

NW/c

SECTION PLAT

0			

330 Ft. from N. Line

_____ Ft. from S. Line

_____ Ft. from E. Line

330 Ft. from W. Line

Stationed

Location _____

Rig up _____

Drilling and Remarks:

Vista 4022

Surf 4192

Cor 4222.

RECORD

Cased 3 1/2 in., 1 1/2 ft.

Sand _____

Gas _____

Oil _____

Total Depth 4280

PRODUCTION

1st 24 hrs. Nat. _____

1st 24 hrs. after shot _____

Gas _____ Cu. Ft.

Dry Hole _____

Abandoned _____

Date

DEC 1 3 1944 . 19

S. J. LEWIS Scout