


Section 14 Township 24 Range 14W

Well No. #1 Miller

Company Shell

Rattlesnake

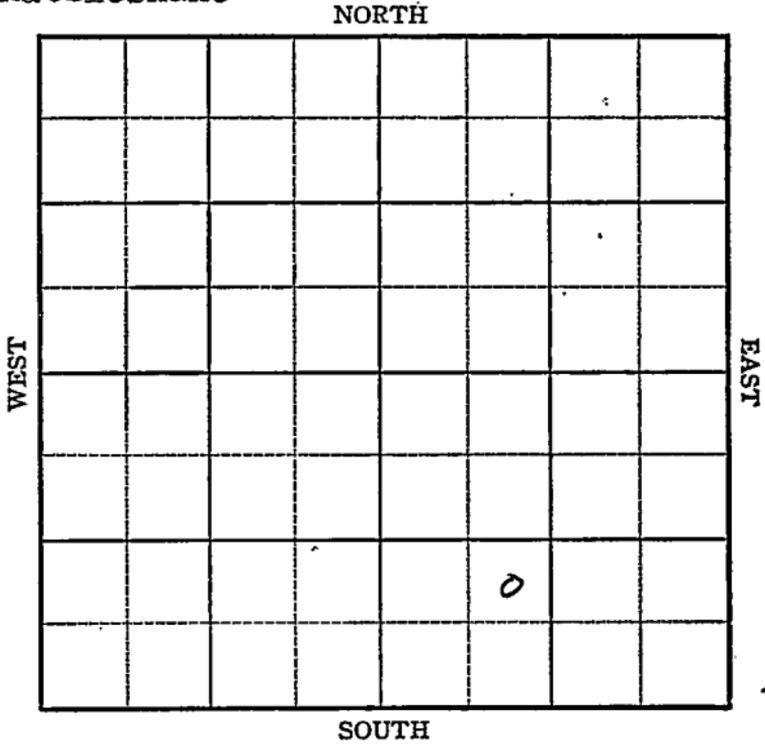

Sec. 14 Twp. 24 R. 14W

Well No. #1 Miller Farm

Shell Company

Rattlesnake Pool

Ft. from N. Line

990'


Ft. from S. Line

Ft. from E. Line

990'

Ft. from W. Line

NE SW SE

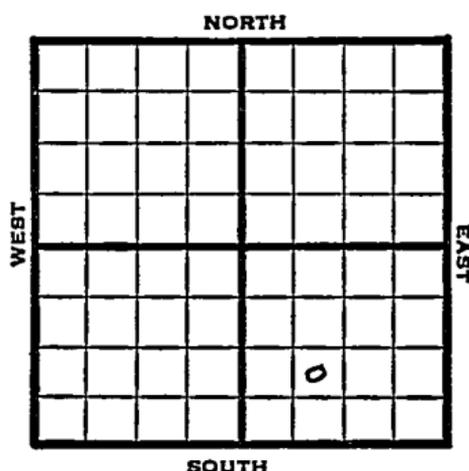

1949

Elev 1927'

REPORT

12/7 12/14 12/21 12/28 2/15	Location 8" @ 825' Drlg 2780' Lansing 3606' Drlg 3820' TD 4310' 8" @ 825' 4½" set 3890' Topeka 3184' Lans 3606' Viola 4061' Simp 4155' plug back to 3795' Perf 20/3776-82 used 500 acid Perf 42/3760-74 used 1500 acid 3000 BOPD Comp COMPLETED
---	---

Kansas

Map No. _____ Sec. 14 Twp. 24 R. 14W

Well No. 1 Miller

Shell Company

Contractor

NE SW SE

FIRST REPORT
SECTION PLAT

_____ Ft. from N. Line

990 Ft. from S. Line

_____ Ft. from E. Line

990 Ft. from W. Line

Stafford County

Location X

Rig up _____

Drilling and Remarks:

RECORD

Cased _____ in., _____ ft.

Sand _____

Gas _____

Oil _____

Total Depth _____

PRODUCTION

1st 24 hrs. Nat. _____

1st 24 hrs. after shot _____

Gas _____ Cu. Ft.

Dry Hole _____

Abandoned _____

Date

DEC 7 1949 19

S. J. LEWIS Scout

play back to 3795
perf. 20/3776-82 used
500 acid

perf 42/3760-74 used 1500 acid.

3000 BOP.D.



FEB 21 1950

- | | |
|----------------|-------|
| Scout Cards | |
| Land Small Map | |
| Land Walk Map | |
| Tracings | |
| France Map | |
| Pierce Map | |
| Misc. | |