

FORM 51 25M 3-49 PETROL

Company Shell
Rattlesnake Pool

NORTH

[illegible]

SOUTE

Stafford

KANSAS

Sec. 14 Twp. 24 R. 14th

Well No. #1 McConnaughey Farm

Shell

Company

Peel

Contractor

Rattlesnake Pool


990' Ft. from N. Line

Ft. from S. Line

330' Ft. from E. Line

Ft. from W. Line

SE NE NE

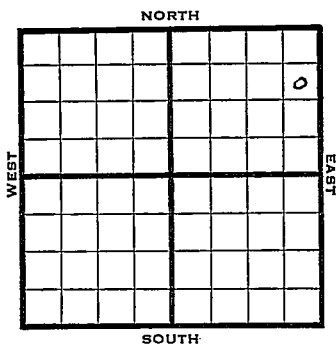

1949

Elev 1924'

REPORT

10/26

Location

11/1

8" @ 824'

Drlg 2140'

11/9

Lansing 3598'

TD 3899'

11/16

TD 3899'

Lansing 3598'

Aband.

ABANDONED

Map No. _____ Sec. 14 Twp. 24 R. 14W

Well No. 1 McConnaughey

_____ Shell _____ Company

_____ Peel _____ Contractor

SE NE NE


**FIRST REPORT
SECTION PLAT**

990 Ft. from N. Line

_____ Ft. from S. Line

330 Ft. from E. Line

_____ Ft. from W. Line

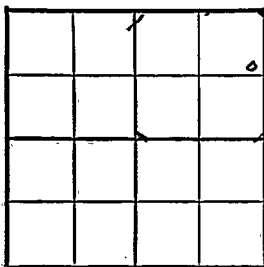

Stafford County

Location X

Rig up _____

Drilling and Remarks:

RECORD

Cased _____ in., _____ ft.

Sand _____

Gas _____

Oil _____

Total Depth _____

PRODUCTION

1st 24 hrs. Nat. _____

1st 24 hrs. after shot _____

Gas _____ Cu. Ft.

Dry Hole _____

Abandoned _____

Date

OCT 26 1949

19

S. J. LEWIS

Scout

Map No. _____ Sec. 14 Twp. 24 R. 14W

Well No. 1 McConnaughey

Shell _____ Company

ABANDONED

Contractor

SE NE NE

E 1/1924
SECTION PLAT

990 Ft. from N. Line

_____ Ft. from S. Line

330 Ft. from E. Line

_____ Ft. from W. Line

			0

Stafford County

Location _____

Rig up _____

Drilling and Remarks:

None 2598

RECORD

Cased _____ in., _____ ft.

Sand _____

Gas _____

Oil _____

Total Depth 2598

PRODUCTION

1st 24 hrs. Nat. _____

1st 24 hrs. after shot _____

Gas _____ Cu. Ft.

Dry Hole _____

Abandoned _____

Date

NOV 16 1949 19

S. J. LEWIS Scout