


Section 14 Township 24 Range 15W

Well No. #1 Isern

Company Greenland Drlg.

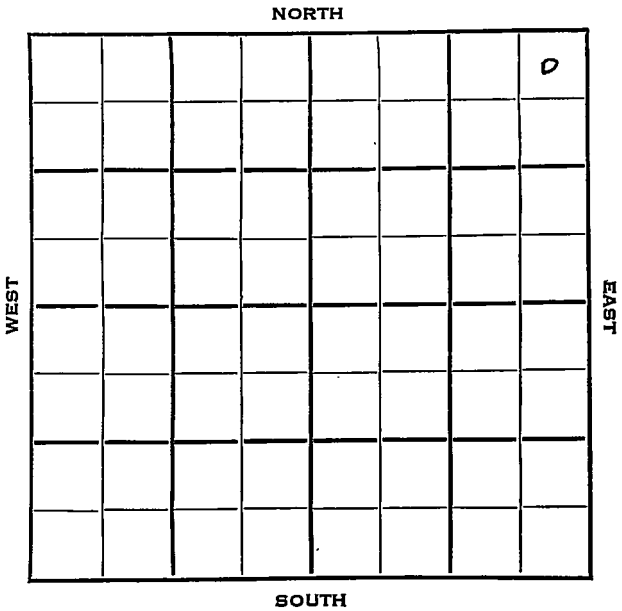

Stafford KANSAS

SEC.	TWP.	R.
14	24	15W ✓

WELL NO.

1 Isern

FARM

COMPANY

Greenland Drlg.

CONTRACTOR

Greenland Drlg.

Wildcat


330 _____ Ft. from N. Line

_____ Ft. from S. Line

330 _____ Ft. from E. Line

_____ Ft. from W. Line

NE NE NE

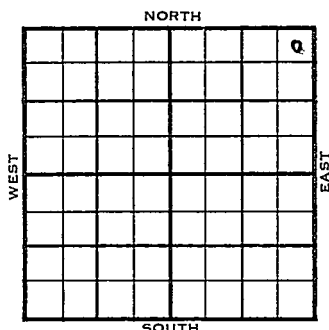

1954

ELEVATION

REPORT

2005'

3/24 Spud 3-17-54
8" @ 215'
Drlg. 3490'

3/31 Heeb 3534', Tor 3553', Doug 3573'
Br. L. 3676', Lans 3686', V 4086'
DST 4089'-4159' 1 hr, F oil in 1 hr,
1325# Simp 4156', Arb 3239'
RTD 4270'
5" @ 4252'
WOCT.

4/7

6/2 Spudding 2-17-54
Oil Well TD 4270 --
8" : 215
Heeb 3534 Tor. 3553 Doug. 3573
Br. Lime 3676 Lans. 3686 Viola 4086
DST 4089-4159 open 1 hr.
F/oil in 1 hr. 1325#
Simp 4156 Arb. 4239
TD. 4270
5" @ 4252 CO to 4270 64/4126 FU1850'
oil 2 hr. E/30 bo 15 min. F/4 boph
12 hr. F/17 boph Comp. F/324 bopd .

COMPLETED

County Stafford State KansasSec. 14 (Blk. Twp.) 24 (Sur. Rge.) 15W Map No.Operator Greenland Drlg.Well No. 1 Farm IsernElev. 2005 Location NE NE NE

						0

330 Ft. From N Line NE330 Ft. From E Line Quarter1st. Report MAR 24 1954

Completion

Remarks

Greenland Drlg. - Contr.Spudding Date 3-17-54

Drlg. Data

Wildcat8" @ 215 drlg. 3490

J. G. MCGEE

County Stafford State Kansas

Sec. 14 (Blk. 24) (Sur. 15W) Map No. _____

Operator Greenland Drlg.

Well No. 1 Farm Isern

Elev.	2005	Location	NE NE NE
-------	------	----------	----------

330 Ft. From N Line NE

330 Ft. From E Line Quarter

1st. Report

Completion JUN 2 1954

Remarks Wildcat

Greenland Drlg. - Contr.

Spudding Date 3-17-54

Drq. Data Oil well TD 4270

8" @ 215 Heeb. 3534 Tor. 3553

Doug. 3573 Br. lime 3676 Lans. 3686

Viola 4086 DST 4089-4159 open 1 hr.

F/ oil in 1 hr. 1325# Simp. 4156

Arb. 4239 TD 4270 5" @ 4252 CO to 4270

64/ 4126-46 FU 1850' oil 2 hr.

F/ 30 bo 15 min. F/ 4 boph 12 hr.

F/ 17 boph Comp. F/ 324 bopd

J. G. McGEHEE