


Section 14 Township 24 Range 24WWell No. #1 JonesCompany Berwick Drlg.

NORTH

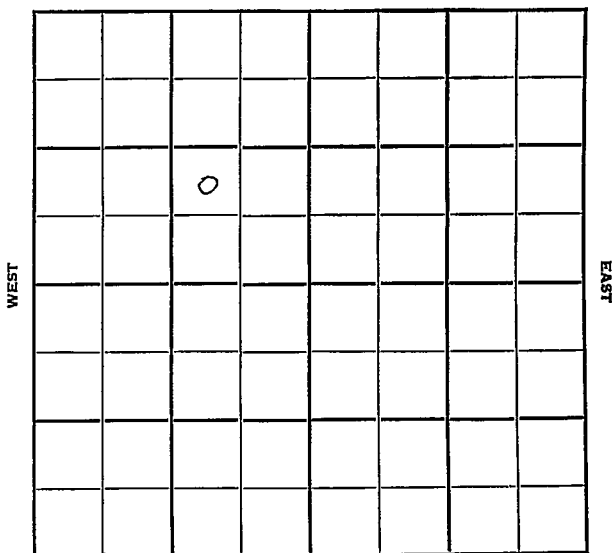

SOUTH

Hodgeman

KANSAS

Sec. 14 Twp. 24 R. 24 W ✓

Well No. # 1 Jones Farm

Berwick Drlg. Company

Berwick Drlg. Contractor

Wildcat


Ft. from N. Line

990 Ft. from S. Line

990 Ft. from E. Line

Ft. from W. Line

NW SE NW

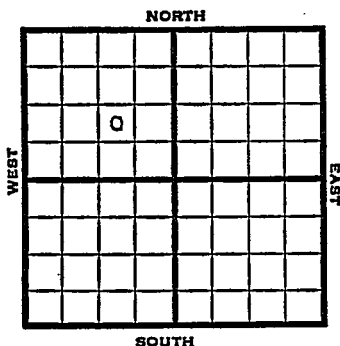

1951

Elev. 2477' REPORT


4/4

Spud 3-31-51
8" @ 176'
Drlg. 1600'

4/25

Spud 3-31-51
D&A TD 4871
8" @ 176'
Anhy 1085-1100 Heeb. 4050
Lans. 4121 Cong. 4768
Miss 4841 TD 4871
D&A

ABANDONED

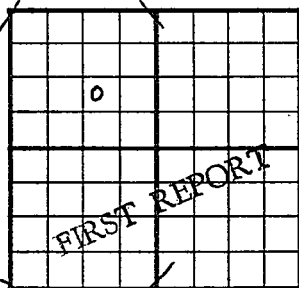
County Hodgeman State KansasSec. 14 (^{Blk.}_{Twp.}) 24 (^{Sur.}_{Rge.}) 24W Map No.Operator Berwick Drlg.Well No. 1 Farm JonesElev. Location NW SE NW990 Ft. From S Line NW990 Ft. From E Line Quarter1st. Report APR 4 1951

Completion

Remarks

Berwick Drlg. - Contr.Spudding Date 3-31-51Drlg. Data Wildcat8" @ 176 drlg. 1600

J. E. TYRA

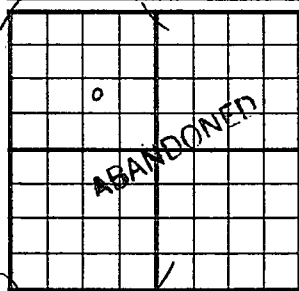County Hodgeman State KansasSec. 14 (Bk.) 24 (Sur.) 24W Map No.Operator Berwick Drlg.Well No. 1 Farm JonesElev. 2477 Location NW SE NW990 Ft. From S Line NW990 Ft. From E Line Quarter1st. ReportCompletion APR 25 1951Remarks WildcatBerwick - Contr.Spudding Date 3-31-51Drlg. Data D & A TD 48718" @ 176 Anhy 1085-1100 Heeb. 4050Lans. 4121 Cong. 4768 Miss. 4841TD 4871 D & A

J. E. TYRA