


KANSAS Finney

Section 14 Township 24 Range 34W

Well No. 12 Brown

Company Northern Natural Gas

Hugoton

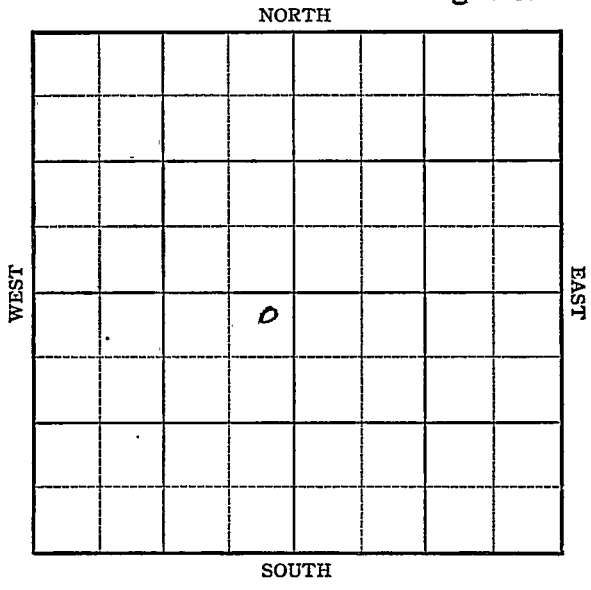

KANSAS

Finney

Sec. 14 Twp. 24 R. 34W ✓

Well No. #12 Brown Farm

Northern Natural Gas Company

Hugoton Pool (Moran, Cont.)


NORTH

200' Ft. from N. Line

_____ Ft. from S. Line

200' Ft. from E. Line

_____ Ft. from W. Line

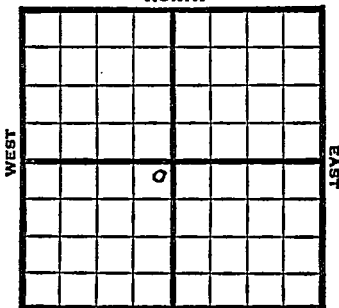

NE SW

SOUTH

1949

^Elev 2902'

REPORT

6/1 RUR
 6/7 10" @ 372'
 6/15 TD 2475'
 7" @ 2462'
 6/21 "
 6/28 TD 2665'
 211' of 5" Perf liner @ 2665'
 7/6 21000 acid
 7/12 "
 7/20 "
 7/27 "
 8/3 "
 8/10 "
 8/17 "
 8/24 TD 2665'
 7" @ 2462'
 211' of 5" Perf Liner @ 2665'
 21000 acid
 19,212,000 Gas
 401# R Pr.
 Comp

COMPLETED

Map No. _____ Sec. 14 Twp. 24 R. 34W

Well No. 12 Brown

Northern Natural Gas Company

Moan Contractor

NE SW

FIRST REPORT
SECTION PLAT

200 Ft. from N. Line

	6		

_____ Ft. from S. Line

200 Ft. from E. Line

_____ Ft. from W. Line

Finney County

Location _____

RECORD

Rig up _____

Drilling and Remarks:

Cased _____ in., _____ ft.

Sand _____

Gas _____

Oil _____

Total Depth _____

R U R

PRODUCTION

1st 24 hrs. Nat. _____

1st 24 hrs. after shot _____

Gas _____ Cu. Ft.

Dry Hole _____

Abandoned _____

Date

JUN 1 1949 19

S. J. LEWIS Scout

