


WELL LOG BUREAU—KANSAS GEOLOGICAL SOCIETY
412 Union National Bk. Bldg., Wichita, Kansas

Company - J. M. HUBER CORP.
Farm - O'Connor No. 1

SEC. 16 T. 24 R. 15 W
CNW NW

Total Depth. 4072'
Comm. 3-28-47 Comp. 4-16-47
Shot or Treated.
Contractor. Coppinger & Southern
Issued. 6-7-47

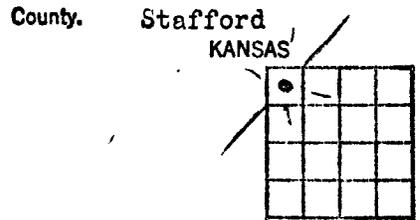

CASING:
10 3/4" 290' Cem. w/165 Sx.
5 1/2" 4064' Cem. w/125 sx.

Elevation. _____

Production. 26,000,000 G.

Figures Indicate Bottom of Formations.

sand & clay	120
clay	180
shale & shells	300
shale	450
water sand	502
red bed	550
shells & shale	845
shale	975
anhydrite	995
shale & shells	1780
lime	1875
lime & shale	2125
lime & shells	2230
lime & shale	2395
lime & shale brks	2505
lime & shale	2805
shale & shells	2915
lime & shale	2993
shale	3075
lime & shale	3150
lime	3365
lime & shale	3425
lime	3565
lime & shale	3597
shale	3665
lime	3742
lime & shale	3784
shale	3789
lime	3950
shale	3999
cherty shale	4030
shale	4060
lime	4064

Total Depth Rotary
lime 4072

Total Depth (Cable)

Tops:

Lansing	3647
Viola	3996
Simpson	4027
Arbuckle	4061