

KANSAS


Harvey

FORM 51 5M 1-42 PETROL

Section 15 Township 24 Range 2-W

Well No. #1 Webster

Company Derby & Sunray

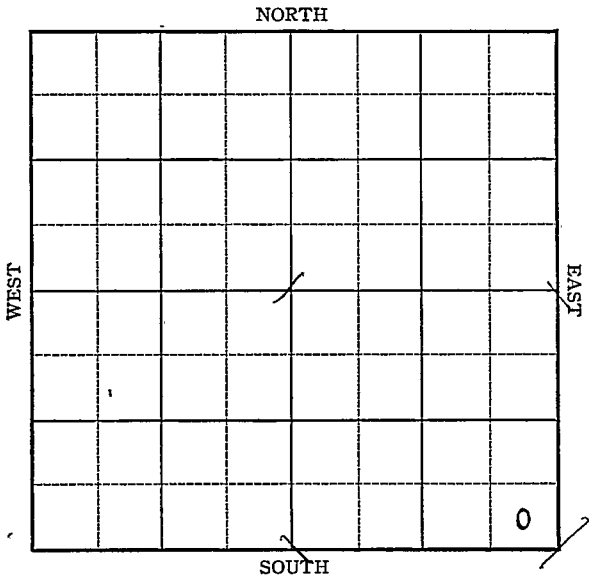

KANSAS

Harvey

Sec. 15 Twp. 24 R. 2-W

Well No. #1 Webster Farm


Derby & Sunray Company

 Ft. from N. Line

330 Ft. from S. Line

330 Ft. from E. Line

 Ft. from W. Line

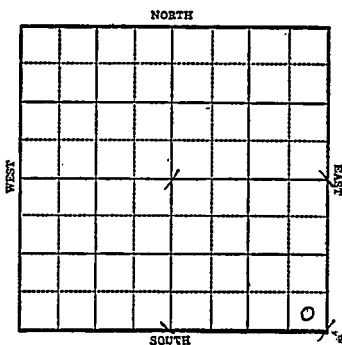

1943

Elev. 1394 R E P O R T

8/11

Surface Hole

8/18

8" @ 803
Drlg. 1930'

8/25

Lans 2475
Drlg. 2987'

9/1

Miss 3322
Drlg. 3610

9/8

Viola 3842
Arb 3942
T.D. 3995

ABANDONED

KANSAS Harvey

Map No. 39 Sec. 15 Twp. 24 R. 2WWell No. 1 WebsterDerby & Sunray

Company

FIRST REPORT

Contractor

SE/C

SECTION PLAT

 Ft. from N. Line330 Ft. from S. Line330 Ft. from E. Line Ft. from W. Line

WIIDCAT

Location Rig up

Drilling and Remarks:

Surface Hole

RECORD

Cased in., ft.Sand Gas Oil Total Depth

PRODUCTION

1st 24 hrs. Nat. 1st 24 hrs. after shot Gas Cu. Ft.Dry Hole Abandoned

Date

AUG 1 1 1943

19

S. I. LEWIS


Scout

KANSAS

Map No. 39 Sec. 15 Twp. 24 R. 2WWell No. 1 WebsterDerby & Sunray CompanyABANDONED Contractor

SE/C

SECTION PLAT

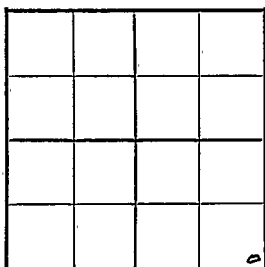 Ft. from N. Line330 Ft. from S. Line330 Ft. from E. Line Ft. from W. Line

Wildcat

Location Rig up

Drilling and Remarks:

*Viola 8842**Ar 8942*

RECORD

Cased in., ft.Sand Gas Oil Total Depth 3225

PRODUCTION

1st 24 hrs. Nat. 1st 24 hrs. after shot Gas Cu. Ft.Dry Hole Abandoned

Date

SEP 8 1943 19S. J. LEWIS Scout