


Reus

Map No. KANSAS Sec. 15 Twp. 24 R. 4W

Well No. 1 Stone Farm _____
Texco Co. Company _____

_____ Ft. from N. Line
660 Ft. from S. Line
_____ Ft. from E. Line
560 Ft. from W. Line

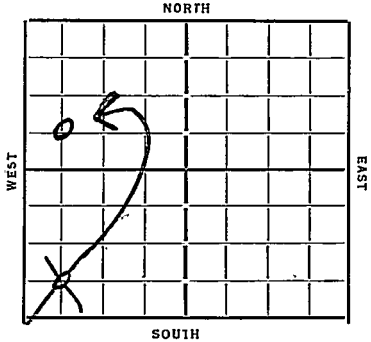

Date 1954

REPORT

<u>10/10</u>	<u>Location</u>
<u>10/18</u>	<u>10/25 - 11/1 - 11/8</u>
<u>11/15</u>	<u>11/22 - 11/28 - 12/6</u>
<u>12/13</u>	<u>12/21 - 12/27 - 1/3/35</u>
<u>1/10</u>	<u>1/17 - 1/24 - 1/31</u>
<u>2/7</u>	<u>2/14 - 2/21 - 2/28</u>
<u>3/7</u>	<u>Rig</u>
<u>3/14</u>	<u>Rgn</u>
<u>3/21</u>	<u>18" 298 WOC</u>
<u>3/28</u>	<u>dlg 2053</u>
<u>4/4</u>	<u>" 3067 HCL 2856</u>
<u>4/11</u>	<u>Chat 3322 8" 3223 Rust</u>
<u>4/18</u>	<u>3350-52 2000' fluid</u> <u>Mostly Water dlg 3400</u>
<u>4/24</u>	<u>dlg 3505</u>
<u>5/2</u>	<u>" 3635 6" 3600 BL 3612</u>
<u>5/8</u>	<u>Hutton 3676 T17 3680</u> <u>D.A.</u>

ABANDONED

Map No. _____ Sec. 15 Twp. 24 R. 4W

Well No. 1-Store
Texas Company

Contractor _____

FIRST REPORTS SECTION PLAT

_____ Ft. from N. Line

660 Ft. from S. Line

_____ Ft. from E. Line

560 Ft. from W. Line

0			

Location ✓

Rig up _____

Drilling and Remarks:

RECORD

Cased _____ in., _____ ft.

Sand _____

Gas _____

Oil _____

Total Depth _____

PRODUCTION

1st 24 hrs. Nat. _____

1st 24 hrs. after shot _____

Gas _____ Cu. Ft.

Dry Hole _____

Abandoned _____

Date

10-10-34 19

ORVAL WANNSCHECK
Scout

Kansas.

26-1M, Bks. 29

Map No. 40 Sec. 15 Twp. 24 R. 4W

Well No. 1 - Stone

Texas Co Company

Contractor

OK. CORRECTION

_____ Ft. from N. Line

660 Ft. from S. Line

_____ Ft. from E. Line

560 Ft. from W. Line

SECTION PLAT

0			

CORRECTION

Location _____

Rig up _____

Drilling and Remarks:

*I think I reported
this well in
the SW quarter
Change to above*

RECORD

Cased _____ in., _____ ft.

Sand _____

Gas _____

Oil _____

Total Depth _____

PRODUCTION

1st 24 hrs. Nat. _____

1st 24 hrs. after shot _____

Gas _____ Cu. Ft.

Dry Hole _____

Abandoned _____

Date

10-11-37 19

RVA MANNSCHRECK
Scout

Map No. 40 Sec. 15 Twp. 24 R. 4W

Well No. 1 - Stone

Texas Co Company

Contractor

ABANDONED

SECTION PLAT

..... Ft. from N. Line

660 Ft. from S. Line

..... Ft. from E. Line

560 Ft. from W. Line

0			

Location

Rig up

Drilling and Remarks:

OK H

RECORD

Cased in. ft.

Sand Hunton 3676

Gas

Oil

Total Depth 3680

PRODUCTION

1st 24 hrs. Nat.

1st 24 hrs. after shot.

Gas Cu. Ft.

Dry Hole

Abandoned

Date

ORVAL MANNSCHRECK

5-8-35 192

Scout