

KANSAS


Stafford

Form 51-5M-7-39-Palace

Section 15 Township 24 Range 11W

Well No. #2 Ferris "A"

Company Stanolind

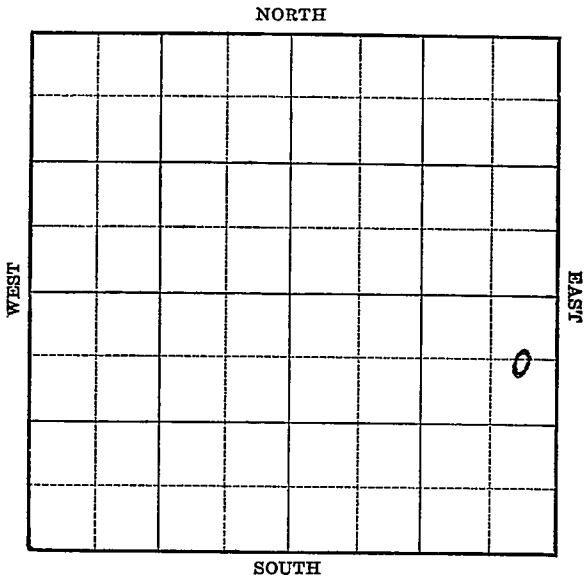

Sec. 15 Twp. 24 R. 11-W

Well No. #2 Ferris "A" Farm

Stanolind Company

Company

(Zenith)


660 Ft. from N. Line

_____ Ft. from S. Line

330 Ft. from E. Line

_____ Ft. from W. Line

Elev. 1814

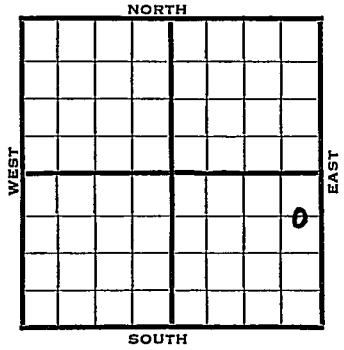

| 1940 | REPORT |
|------|---------------------------|
| 7/10 | Location |
| 7/18 | 10" - 260' Drlg. 960' |
| 7/25 | Drlg. 2290' |
| 8/2 | Drlg. 3781' |
| 8/8 | Coring 3829' S.S.O. |
| | Misener 3781' |
| | |
| 8/14 | Misener 3781' |
| | 5" - 3785' |
| | T.D. 3829' |
| | 3000 acid. |
| | Bomb potential 1913 bbls. |
| | COMPLETED |
| | |
| | |
| | |
| | |
| | |
| | |
| | |

Map No. 47 Sec. 15 Twp. 24 R. 11WWell No. 2 Ferris "A"Stanolind

Company

Contractor

FIRST REPORT

C E L N E S E

SECTION PLAT660 Ft. from N. Line Ft. from S. Line330 Ft. from E. Line Ft. from W. Line

| | | | |
|--|--|--|---|
| | | | |
| | | | |
| | | | b |
| | | | |

ZENITH POOL

Location XRig up Drilling and Remarks: **RECORD**Cased in., ft.Sand Gas Oil Total Depth **PRODUCTION**1st 24 hrs. Nat. 1st 24 hrs. after shot Gas Cu. Ft.Dry Hole Abandoned

Date

JUL 10 1940₁₉S. J. LEWIS Scout

Map No. 47 Sec. 15 Twp. 24 R. 11WWell No. 2 Ferris "A"Stanolind

Company

Contractor

COMPLETED**C E L N E S E****SECTION PLAT**660 Ft. from N. Line

_____ Ft. from S. Line

330 Ft. from E. Line

_____ Ft. from W. Line

ZENITH POOL

| | | | |
|--|--|--|---|
| | | | |
| | | | |
| | | | 2 |
| | | | |

Location _____

Rig up _____

Drilling and Remarks:

*Musnie 28781**5" @ 2785**3000 acid**Boon & P. 1913***RECORD**

Cased _____ in., _____ ft.

Sand _____

Gas _____

Oil _____

Total Depth 3829**PRODUCTION**

1st 24 hrs. Nat. _____

1st 24 hrs. after shot _____

Gas _____ Cu. Ft.

Dry Hole _____

Abandoned _____

Date

AUG 14 1940 19S. J. LEWIS Scout