

KANSAS


Stafford

Form 51-5M-7-40-Palace

Section 15 Township 24 Range 11-W

Well No. #4 Ferris "A"

Company Stanolind

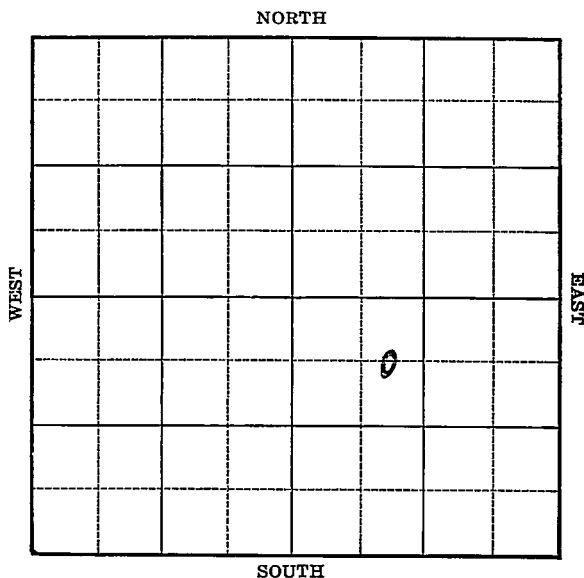

Well No. #4 Ferris "A" Farm

Stan olind _____ Company

(Zenith)


66.0 Ft. from N. Line

Ft. from S. Line

Ft. from E. Line

99.0 Ft. from W. Line

Elev. 1814

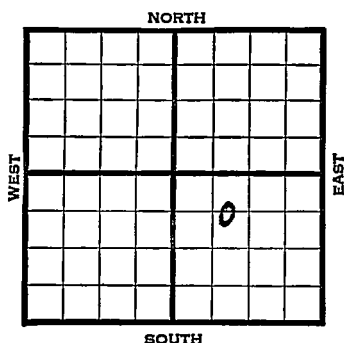[illegible]

Map No. 47 Sec. 15 Twp. 24 R. 11WWell No. 4 Ferris "A"Stanolind CompanyFIRST REPORT Contractor

SECTION PLAT

660 C E L NW SE
Ft. from N. Line

Ft. from S. Line

Ft. from E. Line

990 Ft. from W. Line

ZENITH POOL

Location _____

Rig up _____

Drilling and Remarks:

Cellar

RECORD

Cased _____ in., _____ ft.

Sand _____

Gas _____

Oil _____

Total Depth _____

PRODUCTION

1st 24 hrs. Nat. _____

1st 24 hrs. after shot _____

Gas _____ Cu. Ft.

Dry Hole _____

Abandoned _____

Date

FEB 5 1941 19 S. J. LEWIS Scout

Map No. 47 Sec. 15 Twp. 24 R. 11WWell No. 4 Ferris "A"Stanolind

Company

~~COMPLETED~~

Contractor

C E L NW SE

SECTION PLAT

660 Ft. from N. Line Ft. from S. Line Ft. from E. Line990 Ft. from W. Line

ZENITH POOL

Location Rig up

Drilling and Remarks:

*Vista 8791**5" @ 3786**8000 acid**Boon & P. 411**6**.42 G. Gr.*

RECORD

Cased in., ft.Sand Gas Oil Total Depth 2820

PRODUCTION

1st 24 hrs. Nat. 1st 24 hrs. after shot Gas Cu. Ft.Dry Hole Abandoned

Date

MAR 19 1941 19

S. J. LEWIS Scout