

KANSAS

FORM 51 5M 4-41 PETROL


Stafford

Section 15 Township 24 Range 11-W

Well No. #5 Ferris "A"

Company Stanolind

NORTH Zenith pool

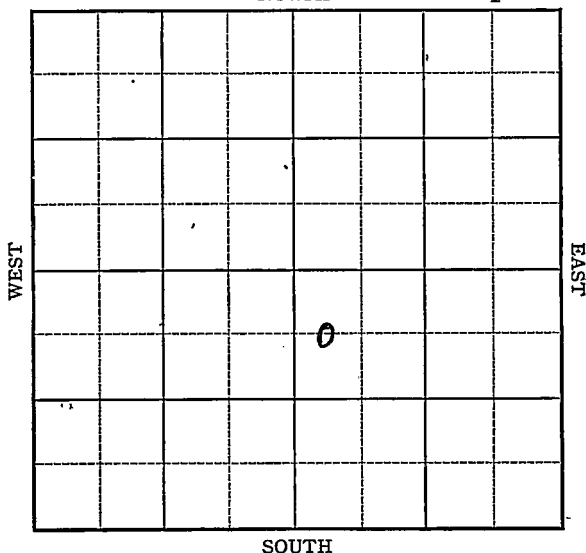

KANSAS

Stafford

Sec. 15 Twp. 24 R. 11-WWell No. #5 Ferris "A" FarmStanolind

Company

(Zenith)

660

Ft. from N. Line


Ft. from S. Line

Ft. from E. Line

330~~990~~

Ft. from W. Line

Elev. 1814

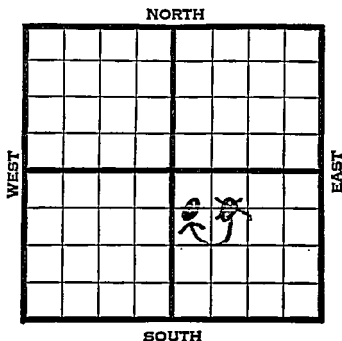

1941	REPORT
5/21	Derrick.
6/5	8" - 257' WOC.
6/12	Drlg. 2950'
6/19	Coring 3785'
6/26	Misener 3783' Viola ~~3783~~ 3815'
	T.D. 3801' 5" - 3785' RUST.
7/3	Viola 3815' (Corrected)
	T.D. 3824' 3000 acid.
	On potential.
7/9	Viola 3815'
	5" - 3785'
	T.D. 3824'
	3000 acid.
	Potential 100 bbls., pump.
	42.6 Gravity
	COMPLETED

Map No. _____ Sec. **15** Twp. **24** R. **11W**

Well No. **5 Ferris "A"**

Stanolind Company

FIRST REPORT Contractor

C E L NW SE

660 Ft. from N. Line

_____ Ft. from S. Line

_____ Ft. from E. Line

990 Ft. from W. Line

SECTION PLAT

		2	

ZENITH POOL

Location _____

Rig up _____

Drilling and Remarks:

Derrick

RECORD

Cased _____ in., _____ ft.

Sand _____

Gas _____

Oil _____

Total Depth _____

PRODUCTION

1st 24 hrs. Nat. _____

1st 24 hrs. after shot _____

Gas _____ Cu. Ft.

Dry Hole _____

Abandoned _____

Date

MAY 21 1941 19 **S. J. LEWIS** Scout

Map No. 47 Sec. 15 Twp. 24 R. 11WWell No. 5 Ferris "A"Stanolind

Company

CORRECTION

Contractor

C W L NW SE

SECTION PLAT

		0	

660 Ft. from N. Line

_____ Ft. from S. Line

_____ Ft. from E. Line

330 Ft. from W. Line

ZENITH POOL

Location _____

Rig up _____

Drilling and Remarks:

Reported

C E L NW SE

RECORD

Cased _____ in., _____ ft.

Sand _____

Gas _____

Oil _____

Total Depth _____

PRODUCTION

1st 24 hrs. Nat. _____

1st 24 hrs. after shot _____

Gas _____ Cu. Ft.

Dry Hole _____

Abandoned _____

Date

19

S. J. LEWIS

Scout

Map No. 47 Sec. 15 Twp. 24 R. 11WWell No. 5 Ferris "A"Stanolind

Company

Contractor

COMPLETED

SECTION PLAT

		6	

C $W\frac{1}{2}$ NW SE
660 Ft. from N. Line

Ft. from S. Line

330 Ft. from E. Line

Ft. from W. Line

ZENITH POOL

Location

Rig up

Drilling and Remarks:

*Vista 3815**5-163785**2000 acid**Pump 100 P.S.**42 6/4*

RECORD

Cased _____ in., _____ ft.

Sand _____

Gas _____

Oil _____

Total Depth *3824*

PRODUCTION

1st 24 hrs. Nat. _____

1st 24 hrs. after shot _____

Gas _____ Cu. Ft.

Dry Hole _____

Abandoned _____

Date

JUL 9 1941 19S. J. LEWIS Scout