

KANSAS


FORM 51 5M 4-41 PETROL

Stafford

Section 15 Township 24 Range 11W

Well No. 6 Ferris "A"

Company Stanolind

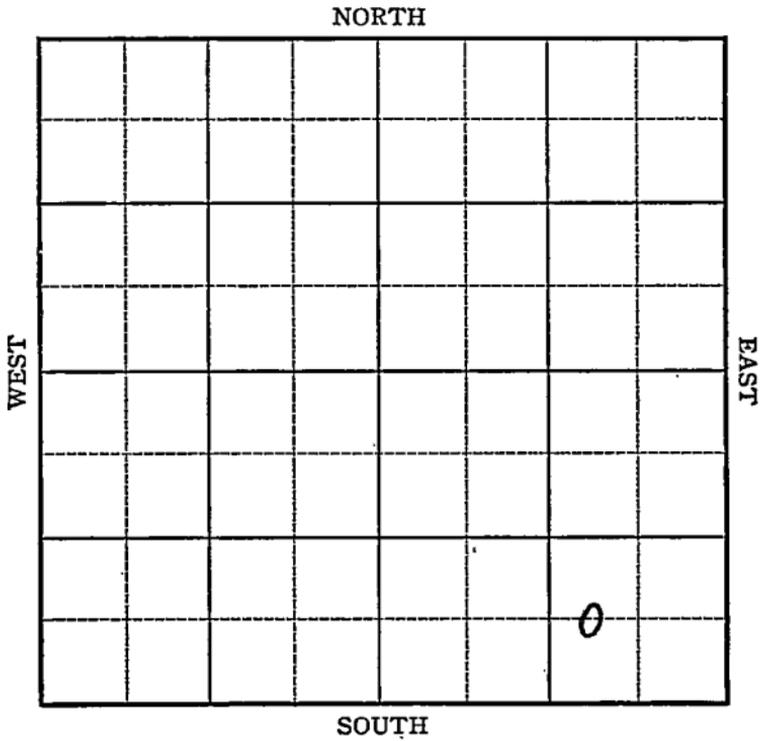

Sec. 15 Twp. 24 R. 11-W

Well No. #6 Ferris "A" Farm

Stanolind Company

(Zenith)


_____ Ft. from N. Line

660 Ft. from S. Line

990 Ft. from E. Line

_____ Ft. from W. Line

Elev. 1818

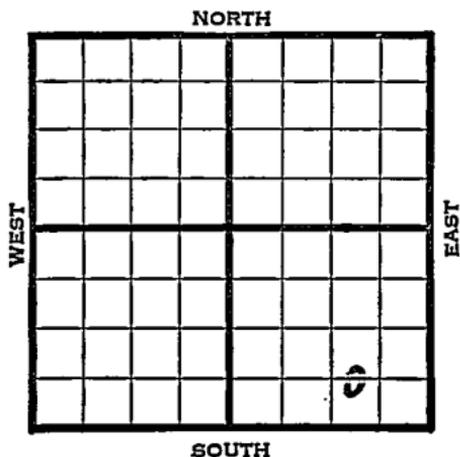

1941	REPORT
6/4	R.O.G.
6/12	"
6/19	8" - 232' Drlg. 570'
6/26	Drlg. 3175'
7/3	Misener 3798' Viola 3819'
	Run casing.
7/10	5" - 3807' T.D. 3821'
	3000 acid. Flow 30 oil per hour
	3 hours.
7/16	Viola 3819'
	5" - 3807'
	T.D. 3832'
	3000 acid.
	Bomb potential 1593 bbls.
	33. Gravity
	COMPLETED

Map No. 47 Sec. 15 Twp. 24 R. 11W

Well No. 6 Ferris "A"

Stanolind Company

Contractor

FIRST REPORT

SECTION PLAT

C W L SE SE

			6

_____ Ft. from N. Line

660 Ft. from S. Line

990 Ft. from E. Line

_____ Ft. from W. Line

ZENITH POOL

Location _____

Rig up _____

Drilling and Remarks:

ROG

RECORD

Cased _____ in., _____ ft.

Sand _____

Gas _____

Oil 5 1/2 _____

Total Depth _____

PRODUCTION

1st 24 hrs. Nat. _____

1st 24 hrs. after shot _____

Gas _____ Cu. Ft.

Dry Hole _____

Abandoned _____

Date

JUN 4 1941 19

S. J. LEWIS Scout

Map No. 47 Sec. 15 Twp. 24 R. 11W

Well No. 6 Ferris "A"

Stanolind Company

Contractor

COMPLETED

SECTION PLAT

C W L SE SE

			D

Ft. from N. Line

660 Ft. from S. Line

990 Ft. from E. Line

Ft. from W. Line

ZENITH POOL

RECORD

Location _____

Cased _____ in., _____ ft.

Rig up _____

Sand _____

Drilling and Remarks:

Gas _____

✓ 12 3819

Oil _____

5" @ 3807

Total Depth 3832

3000 acid

Bout 1553 P.Y.

PRODUCTION

1st 24 hrs. Nat. _____

1st 24 hrs. after shot _____

Gas _____ Cu. Ft.

Dry Hole _____

Abandoned _____

330 4/2

Date

JUL 16 1941 19

S. J. LEWIS Scout