

KANSAS

Form 51-5M-7-40-Palace


Stafford

Section 15 Township 24 Range 11-W

Well No. #1 Kirkpatrick

Company Stanolind

NORTH Zenith Pool

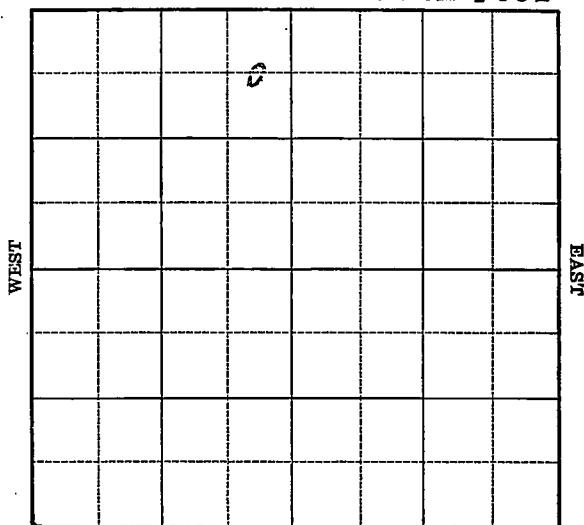

KANSAS


Stafford

Sec. 15 Twp. 24 R. 11-WWell No. #1 Kirkpatrick FarmStanolin Company

(Zenith)

660 Ft. from N. Line Ft. from S. Line330 Ft. from E. Line Ft. from W. Line

Elev. 1815

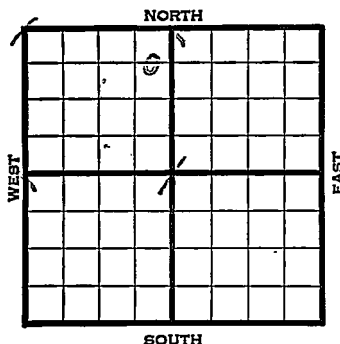

1941

REPORT

1/8

Location

1/16

8" - 258' WOC.

1/23

Drlg. 2175'

1/30

Drlg. 3535'

2/6

Misener 3790' Viola 3818-27'

T.D. 3727' Sat. Run pipe.

2/13

5" - 3818' Swab 29 oil per 4
hours.

2/19

Viola 3818'

5" - 3818'

T.D. 3827'

3000 acid.

Bomb potential 8975 bbls.

Maximum 3000 bbls.


42.6 Gravity

COMPLETED

Map No. 47 Sec. 15 Twp. 24 R. 11WWell No. 1 KirkpatrickStanolind

Company

Contractor

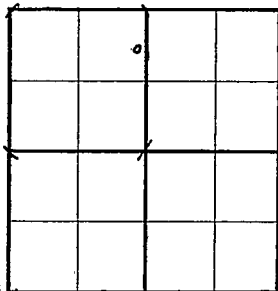FIRST REPORT**C E L NE NW****SECTION PLAT**660 Ft. from N. Line Ft. from S. Line330 Ft. from E. Line Ft. from W. Line**ZENITH POOL**Location XRig up

Drilling and Remarks:

RECORDCased in., ft.Sand Gas Oil Total Depth **PRODUCTION**1st 24 hrs. Nat. 1st 24 hrs. after shot Gas Cu. Ft.Dry Hole Abandoned

Date

JAN 8 1911 19S. J. LEWIS

Scout

Map No. 47 Sec. 15 Twp. 24 R. 11WWell No. 1 KirkpatrickStanolind Company

Contractor

COMPLETED

C E L NE NW

660 Ft. from N. Line

Ft. from S. Line

330 Ft. from E. Line

Ft. from W. Line

SECTION PLAT

	o		

ZENITH POOL

Location _____

Rig up _____

Drilling and Remarks:

*Vista 3818.**5" @ 3818**3000 acid**Brn & Rd 8975**May 3000**42 @ Gr***RECORD**

Cased _____ in., _____ ft.

Sand _____

Gas _____

Oil _____

Total Depth 3827**PRODUCTION**

1st 24 hrs.-Nat. _____

1st 24 hrs. after shot _____

Gas _____ Cu. Ft.

Dry Hole _____

Abandoned _____

Date

FEB 19 1941 19

S. J. LEWIS Scout