

KANSAS

FORM 51 5M 4-41 PETROL

Stafford

Section 15 Township 24 Range 11-W

Well No. #3 Kirkpatrick


Company Stanolind

Zenith Pool

NORTH

WEST

EAST

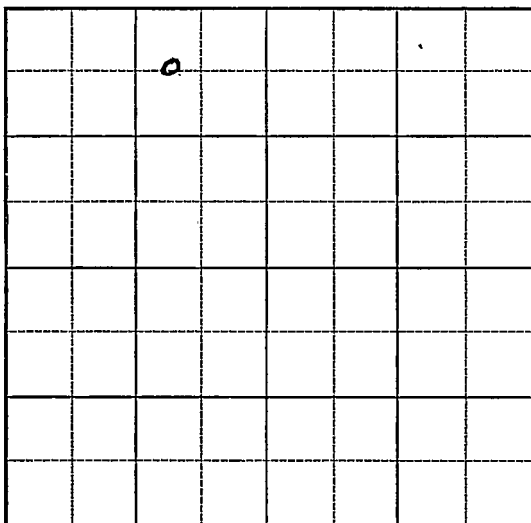

SOUTH


Sec. 15 Twp. 24 R. 11-WWell No. #3 Kirkpatrick FarmStanolin

Company

(Zenith)

660 Ft. from N. Line Ft. from S. Line990 Ft. from E. Line380 Ft. from W. Line

Elev. 1815

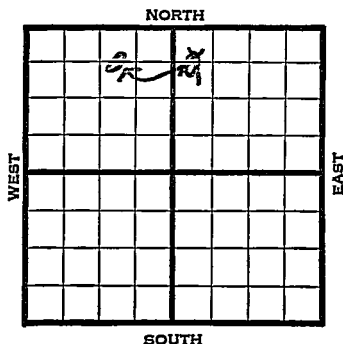

	REPORT
1941	
4/30	Derrick.
5/8	"
5/15	Surface hole.
5/22	8" - 261' Drlg. 2480'
5/28	Drlg. 3595'
6/5	Viola 3817' T.D. 3827'
	5" - 3820' Flow 46 oil in 2
	hours.
6/11	Viola 3817'
	5" - 3820'
	T.D. 3827'
	3000 acid.
	Bomb potential 9700 bbls.
	Maximum 3000 bbls.
	42.6 Gravity
	COMPLETED

Map No. 47 Sec. 15 Twp. 24 R. 11WWell No. 3 KirkpatrickStanolind

Company

~~FOOT SECTION~~

Contractor

FIRST REPORT

C W L NE NW

660 Ft. from N. Line Ft. from S. Line990 Ft. from E. Line Ft. from W. Line

ZENITH POOL

SECTION PLAT

	0		

Location Rig up

Drilling and Remarks:

Reported

C W L NW NE

RECORDCased in., ft.Sand Gas Oil Total Depth **PRODUCTION**1st 24 hrs. Nat. 1st 24 hrs. after shot Gas Cu. Ft.Dry Hole Abandoned

Date

APR 30 1941 19S. J. LEWIS

Scout

Map No. 47 Sec. 15 Twp. 24 R. 11WWell No. 3 KirkpatrickStanolind

Company

COMPLETED

Contractor

SECTION PLAT

C W L NE NW

660 Ft. from N. Line Ft. from S. Line Ft. from E. Line330 Ft. from W. Line

ZENITH POOL

Location Rig up

Drilling and Remarks:

1 1/2 in 38175" @ 38203000 acidBomb 8 9700Max 300042 1/2 Gr

RECORD

Cased in., ft.Sand Gas Oil Total Depth 3827

PRODUCTION

1st 24 hrs.-Nat. 1st 24 hrs: after shot Gas Cu. Ft.Dry Hole Abandoned

Date

JUN 1 1 1941S. J. LEWIS

Scout