

KANSAS


Form 51-5M-7-40-Palace

Stafford

Section 15 Township 24 Range 12-W

Well No. #4 Charles

Company Stanolind

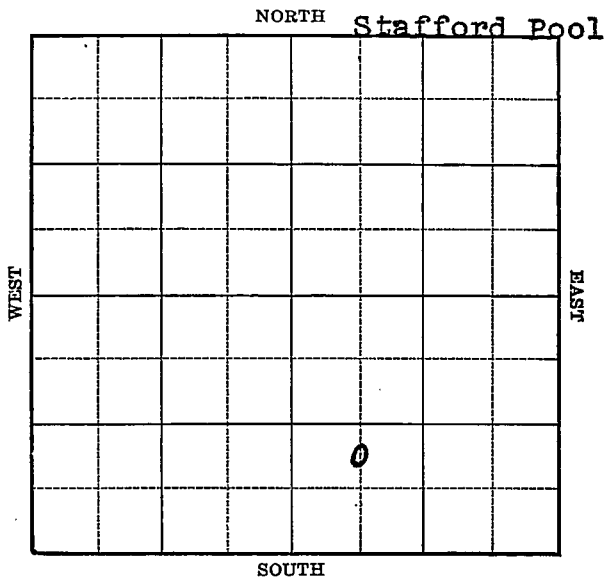

KANSAS


Stafford

Sec. 15 Twp. 24 R. 12 WWell No. #4 Charles FarmStanolind Company

(Stafford)

 Ft. from N. Line990 Ft. from S. Line Ft. from E. Line660 Ft. from W. Line

Elev. 1872

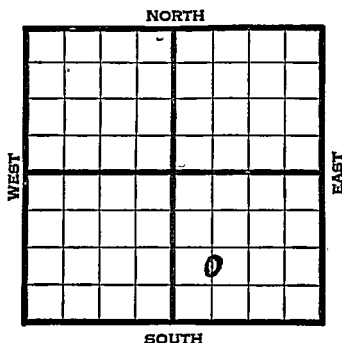

1941	REPORT
2/26	Location
3/6	8" - 253' Drlg. 400'
3/13	Anhy 656' Drlg. 3130'
3/20	Viola 3775' No shows.
	Simpson 3883' Coring 3948'
3/27	Arh. 3945' 5" - 3946'
	T.D. 3955' RUST.
4/3	500 acid. Testing.
4/10	T.D. 3953' 1000 acid.
	H.F.W. P.B.
4/18	132 shots 3826-3773'
	S/oil 3812-16' P.B. to 3818'
	1000 acid. P.B. to 3812'
	2000 acid. SO & Water.
4/24	Shut down.
5/1	" "
5/8	" "
	OVER

1941

5/14

Arb. 3945'

5" - 3946'

T.D. 3964'

500 acid.

Depthograph potential 1098 bbls.
plus 98 bbls. water.

42.6 Gravity

COMPLETED

Map No. 47 Sec. 15 Twp. 24 R. 12WWell No. 4 CharlesStanolind CompanyFIRST REPORT Contractor

C N L SW SE

 Ft. from N. Line990 Ft. from S. Line Ft. from E. Line660 Ft. from W. Line

STAFFORD POOL

SECTION PLAT

		0	

Location XRig up

Drilling and Remarks:

RECORD

Cased in., ft.Sand Gas Oil Total Depth

PRODUCTION

1st 24 hrs. Nat. 1st 24 hrs. after shot Gas Cu. Ft.Dry Hole Abandoned

Date

FEB 26 1941 19

S. J. LEWIS Scout

Map No. 47 Sec. 15 Twp. 24 R. 12WWell No. 4 CharlesStanolind

Company

COMPLETED

Contractor

C N L SW SE

SECTION PLAT

		0	

 Ft. from N. Line990 Ft. from S. Line Ft. from E. Line660 Ft. from W. Line

STAFFORD POOL

Location Rig up

Drilling and Remarks:

CR 89455" @ 3946.500 acs lD. J. H. P. 81098.9888 1/2 Water42 1/2 Gr.

RECORD

Cased in., ft.Sand Gas Oil Total Depth 3964

PRODUCTION

1st 24 hrs. Nat. 1st 24 hrs. after shot Gas Cu. Ft.Dry Hole Abandoned

Date

MAY 14 1941 19S. J. LEWIS Scout