

KANSAS


Form 51-5M-7-40-Palace

Stafford

Section 15 Township 24 Range 12-W

Well No. #1 Crawford

Company Stanolind

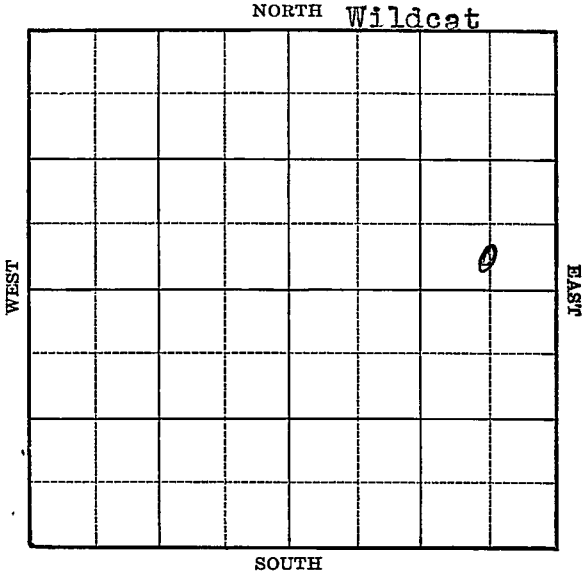

Sec. 15 Twp. 24 R. 12-W

Well No. #1 Crawford Farm

Stanolind Company

(Wildcat)


_____ Ft. from N. Line

330 Ft. from S. Line

660 Ft. from E. Line

_____ Ft. from W. Line

Elev. 1875

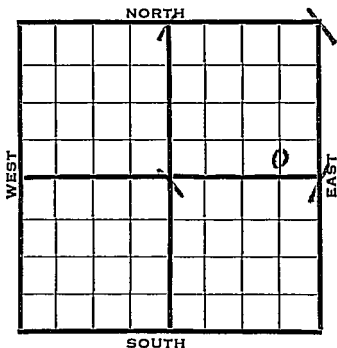

1940	REPORT
8/14	Derrick.
8/22	8" - 245' Anhy 647'
	Drlg. 2210'
8/29	Lans. 3462' Drlg. 3540'
9/5	Viola 3813-37' T.D. Saturation
	5" - 3814' RUST.
9/12	T.D. 3845' 3000 acid.
	Flow 173 bbls. in 2 hours.
9/18	Viola 3813'
	5" - 3814'
	T.D. 3845'
	3000 acid.
	Bomb potential 22,167 bbls.
	Maximum 3000 bbls.
	COMPLETED

Map No. _____ Sec. 15 Twp. 24 R. 12W

Well No. 1 Crawford

Stanolind _____ Company

Contractor

SECTION PLAT

C S L SE NE

_____ Ft. from N. Line

330 Ft. from S. Line

660 Ft. from E. Line

_____ Ft. from W. Line

			o

WILDCAT

Location _____

Rig up _____

Drilling and Remarks:

Derrick

RECORD

Cased _____ in., _____ ft.

Sand _____

Gas _____

Oil _____

Total Depth _____

PRODUCTION

1st 24 hrs. Nat. _____

1st 24 hrs. after shot _____

Gas _____ Cu. Ft.

Dry Hole _____

Abandoned _____

Date

AUG 14 1940

19

S. J. LEWIS Scout

Map No. 47 Sec. 15 Twp. 24 R. 12WWell No. 1 CrawfordStanolind

Company

Contractor

COMPLETED**C S L S E N E****SECTION PLAT**

			0

_____ Ft. from N. Line

330 Ft. from S. Line660 Ft. from E. Line

_____ Ft. from W. Line

WILDCAT

Location _____

Rig up _____

Drilling and Remarks:

Viola 3813
5" @ 3814.
3000 acid
Bone & Pat 22167

Map 3000

RECORD

Cased _____ in., _____ ft.

Sand _____

Gas _____

Oil _____

Total Depth 3845**PRODUCTION**

1st 24 hrs. Nat. _____

1st 24 hrs. after shot _____

Gas _____ Cu. Ft.

Dry Hole _____

Abandoned _____

Date

SEP 18 1940

19

S. J. LEWIS

Scout