

Stafford


KANSAS

FORM 51 5M 10-41 PETROL

Section 15 Township 24 Range 12-W

Well No. 7 Crawford

Company Stanolind

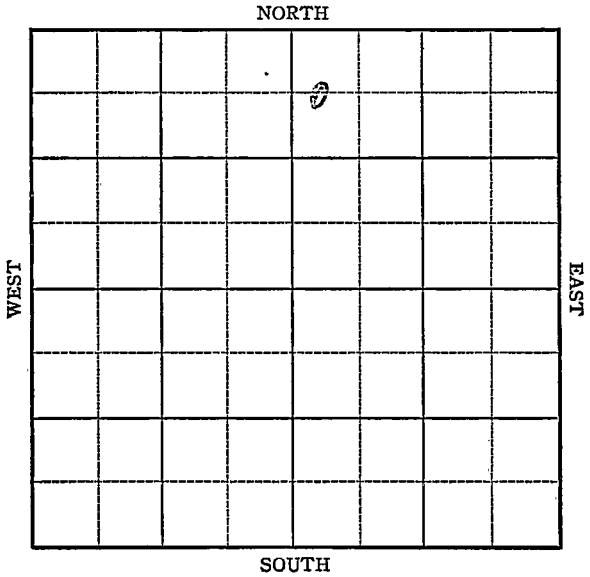

Sec. 15 Twp. 24 R. 12-W

Well No. #7 Crawford Farm

Stanolind Company

(Zenith)


660 Ft. from N. Line

\_\_\_\_\_ Ft. from S. Line

\_\_\_\_\_ Ft. from E. Line

330 Ft. from W. Line

Elev. 1878

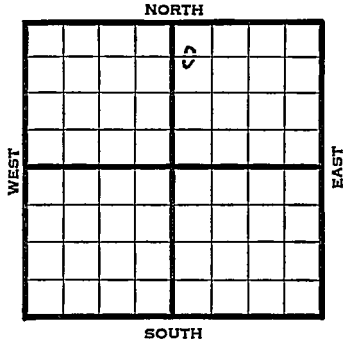

| 1941  | REPORT   |
|-------|--|
| 11/19 | Derrick.   |
| 11/28 | "  |
| 12/4  | Rotary.  |
| 12/11 | 8" @ 240 Anhy 648<br>Drlg. 2180  |
| 12/18 | Drlg. 3400   |
| 12/24 | Viola 3838-48' T.D. 5" - 3839'<br>RUST. S.O.   |
| 12/31 | " "  |
| 1942  |  |
| 1/7   | Viola 3838'<br>5" - 3839'<br>T.D. 3848'<br>3000 acid.<br>Bomb potential 4830 bbls.<br>Maximum 3000 bbls.<br>40.7 Gravity |
|       | <b>COMPLETED</b>   |

Map No. K-47 Sec. 15 Twp. 24 R. 12W

Well No. 7 Crawford

Stanolind Company

**FIRST REPORT** Contractor

C WL NW NE

**SECTION PLAT**

660 Ft. from N. Line

\_\_\_\_\_ Ft. from S. Line

\_\_\_\_\_ Ft. from E. Line

330 Ft. from W. Line

|  |  |   |  |
|--|--|---|--|
|  |  | o |  |
|  |  |   |  |
|  |  |   |  |
|  |  |   |  |

**ZENITH POOL**

Location \_\_\_\_\_

Rig up \_\_\_\_\_

Drilling and Remarks:

Derrick

**RECORD**

Cased \_\_\_\_\_ in., \_\_\_\_\_ ft.

Sand \_\_\_\_\_

Gas \_\_\_\_\_

Oil \_\_\_\_\_

Total Depth \_\_\_\_\_

**PRODUCTION**

1st 24 hrs. Nat. \_\_\_\_\_

1st 24 hrs. after shot \_\_\_\_\_

Gas \_\_\_\_\_ Cu. Ft.

Dry Hole \_\_\_\_\_

Abandoned \_\_\_\_\_

Date

NOV 19 1941

19

S. J. LEWIS

Scout

Map No. 47 Sec. 15 Twp. 24 R. 12W

Well No. 7 Crawford

Stanolind Company

**COMPLETED** Contractor

C WL NW NE

SECTION PLAT

660 Ft. from N. Line

\_\_\_\_\_ Ft. from S. Line

\_\_\_\_\_ Ft. from E. Line

330 Ft. from W. Line

|  |  |   |  |
|--|--|---|--|
|  |  | 0 |  |
|  |  |   |  |
|  |  |   |  |
|  |  |   |  |

ZENITH POOL

Location \_\_\_\_\_

Rig up \_\_\_\_\_

Drilling and Remarks:

*Vidla 3735.*  
*5" @ 3839*  
*3000 acid*  
*Bon + 4830 PT*  
*Max 3000*  
*402 1/2*

RECORD

Cased \_\_\_\_\_ in., \_\_\_\_\_ ft.

Sand \_\_\_\_\_

Gas \_\_\_\_\_

Oil \_\_\_\_\_

Total Depth 3845

PRODUCTION

1st 24 hrs. Nat. \_\_\_\_\_

1st 24 hrs. after shot \_\_\_\_\_

Gas \_\_\_\_\_ Cu. Ft.

Dry Hole \_\_\_\_\_

Abandoned \_\_\_\_\_

Date

JAN 7 1942 19

S. J. LEWIS Scout