

Stafford


Form 51-5M-11-38-Palace

KANSAS

Section 15 Township 24 Range 13-W

Well No. #1 Keller

Company Continental et al

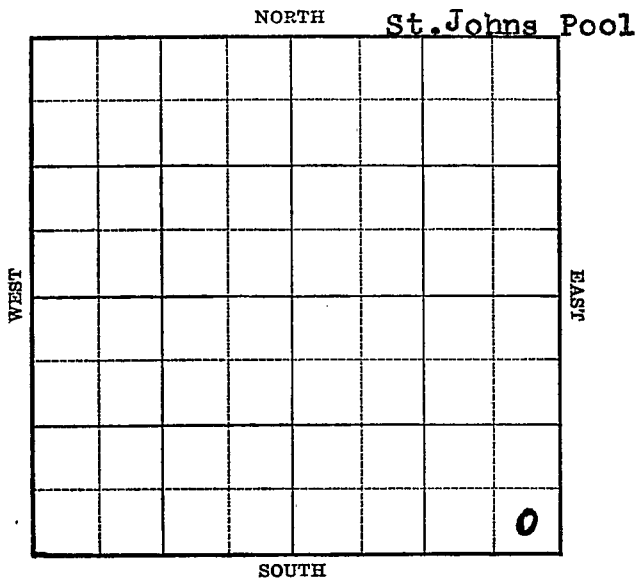

KANSAS


Stafford

Sec. 15 Twp. 24 R. 13-WWell No. #1 Keller FarmContinental et al Company

(St. Johns)

 Ft. from N. Line330 Ft. from S. Line330 Ft. from E. Line Ft. from W. Line

Elev. 1913

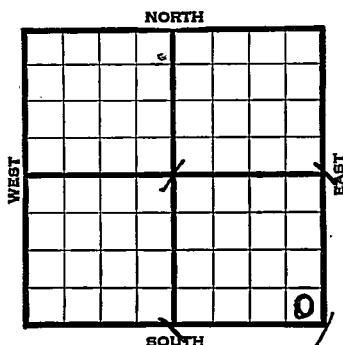

1939	REPORT
6/21	Location
6/29	"
7/6	"
7/13	Rotary.
7/20	10" - 451' Anhy 757'
	Drlg. 1901'
7/27	Topeka 3070' Lans. 3545' 3560'
	Drlg. 3775'
8/3	Lans. 3560' (Corrected)
	Cong. 3885' Viola 3920'
	Arb. 4109' T.D. 4116'
	7" - 4110' RUST.
8/10	3800' oil 16 hours.
	SD for tanks.
8/17	" " "
8/24	" " "
8/31	" " "
9/7	Run tubing.
	OVER

1939

9/13

Arb. ~~XXXX~~ 4109'

7" - 4110'

T.D. 4116'

1000 acid.

Pump 1171 oil & 12 water.

COMPLETED

Stafford KANSAS

Map No. 83 Sec. 15 Twp. 24 R. 13WWell No. 1 KellerContinental etal

Company

Contractor

FIRST REPORT

SE/C

 Ft. from N. Line330 Ft. from S. Line330 Ft. from E. Line Ft. from W. Line

ST. JOHNS POOL

SECTION PLAT

Location XRig up Drilling and Remarks:

RECORD

Cased in., ft.Sand Gas Oil Total Depth

PRODUCTION

1st 24 hrs. Nat. 1st 24 hrs. after shot Gas Cu. Ft.Dry Hole Abandoned

Date

May 21 1939

19

S. J. LEWIS

Scout

Map No. 83 Sec. 15 Twp. 24 R. 13WWell No. 1 KellerContinental etal

Company

Contractor


COMPLETE

SE/C

 Ft. from N. Line330 Ft. from S. Line330 Ft. from E. Line Ft. from W. Line

ST. JOHNS POOL

SECTION PLAT

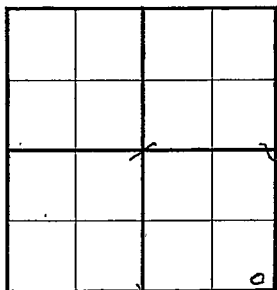Location Rig up Drilling and Remarks *Cr 84#09**7" C 4110**1000 acid**Pump 1171 oil**12 water.*

RECORD

Cased in., ft.Sand Gas Oil Total Depth 4116

PRODUCTION

1st 24 hrs. Nat. 1st 24 hrs. after shot Gas Cu. Ft.Dry Hole Abandoned

Date

SEP 13 1939

19

S. J. LEWIS

Scout