


Section 15 Township 24 Range 14W

Well No. #1 Hager

Company Joe Mishler

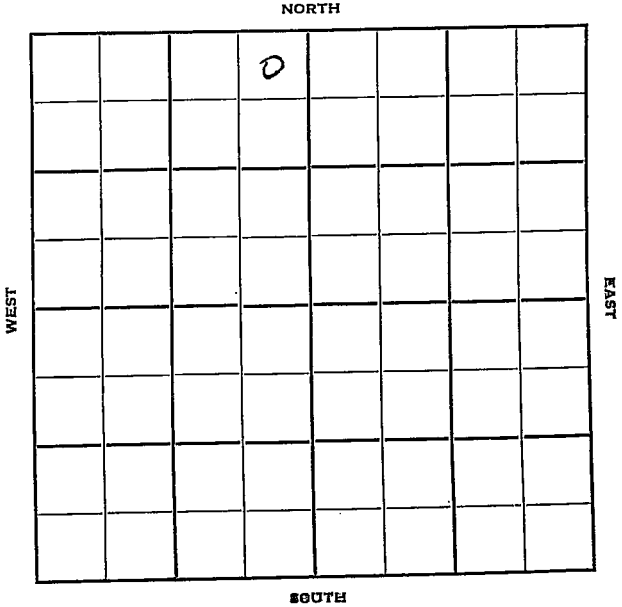

15

24

14W

Sec. \_\_\_\_\_ Twp. \_\_\_\_\_ R. \_\_\_\_\_

#1 Hager

Well No. \_\_\_\_\_ Farm \_\_\_\_\_

Joe Mishler

Company \_\_\_\_\_

Strain D<sub>r</sub>lg.

Contractor \_\_\_\_\_

Rattlesnake Pool


330' Ft. from N. Line

\_\_\_\_\_ Ft. from S. Line

330' Ft. from E. Line

\_\_\_\_\_ Ft. from W. Line

NE NE NW

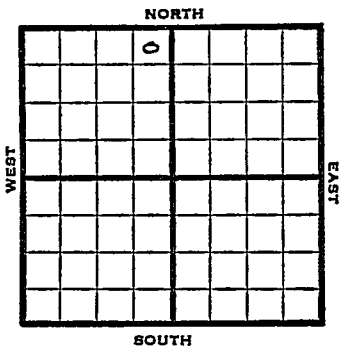

1950

Elev 1966

REPORT

5/3 Spud 4-29-50  
 8" @ 200'  
 Anhy 888'  
 Drlg. 1290'

5/17 TD 4272  
 8" @ 200  
 Heeb 3508  
 Lans 3673  
 Miss 4048  
 Viola 4138  
 Simp 4198  
 Arb 4253-72  
 D&A

**ABANDONED**

*Kansas*

 Map No. \_\_\_\_\_ Sec. 15 Twp. 24 R. 14W
Well No. 1 Hager

\_\_\_\_\_ Joe Mishler \_\_\_\_\_ Company

\_\_\_\_\_ Strain Drlg. \_\_\_\_\_ Contractor

NE NE NW

330 Ft. from N. Line

\_\_\_\_\_ Ft. from S. Line

330 Ft. from E. Line

\_\_\_\_\_ Ft. from W. Line

Stafford County

## SECTION PLAT

	0		

FIRST REPORT

Location \_\_\_\_\_

Rig up \_\_\_\_\_

Drilling and Remarks:

Spud 4-29-50

8" @ 200

Anhy 888

drlg. 1290

## RECORD

Cased \_\_\_\_\_ in., \_\_\_\_\_ ft.

Sand \_\_\_\_\_

Gas \_\_\_\_\_

Oil \_\_\_\_\_

Total Depth \_\_\_\_\_

## PRODUCTION

1st 24 hrs. Nat. \_\_\_\_\_

1st 24 hrs. after shot \_\_\_\_\_

Gas \_\_\_\_\_ Cu. Ft.

Dry Hole \_\_\_\_\_

Abandoned \_\_\_\_\_

Date

MAY 3 1950 19

J. E. TYRA

Scout

Kansas

Map No. \_\_\_\_\_ Sec. 15 Twp. 24 R. 14W

Well No. 1 Hager

Joe Mishler \_\_\_\_\_ Company

Contractor

NE NE NW


El. 1966  
SECTION PLAT

330 Ft. from N. Line

\_\_\_\_\_ Ft. from S. Line

330 Ft. from E. Line

\_\_\_\_\_ Ft. from W. Line

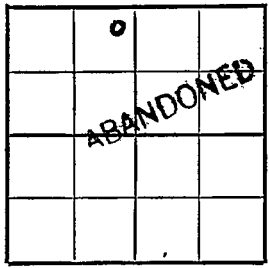

Stafford

Location \_\_\_\_\_

Rig up \_\_\_\_\_

Drilling and Remarks:

8" @ 200  
 Heb- 3508  
 Lans 3673  
 Miss 4048  
 Viola 4138  
 Seng 4198

RECORD

Cased \_\_\_\_\_ in., \_\_\_\_\_ ft.  
 Sand \_\_\_\_\_  
 Gas \_\_\_\_\_  
 Oil \_\_\_\_\_  
 Total Depth 4272

PRODUCTION

1st 24 hrs. Nat. \_\_\_\_\_  
 1st 24 hrs. after shot \_\_\_\_\_  
 Gas \_\_\_\_\_ Cu. Ft.  
 Dry Hole \_\_\_\_\_  
 Abandoned \_\_\_\_\_

Date Feb 4253-22 D+A

MAY 17 1950

J. E. TYRA

Scout