

15-047-50023-0001

GLOBE OILWELL CEMENTING, Inc.

TEMPERATURE SURVEY

Date..... 3-21-71 Place..... Belpre, Kansas

Company Name..... Messman - Rinehart Oil Co. Order No.....

Mail Address..... 1432 Wichita Plaza City..... Wichita State..... Kansas

Owner of Well..... same Contractor..... Abercrombie Drlg.


Well No. 3 Farm Hahn County Edwards Sec. 4 Tp. 24S Rge. 16W

Depth of Well 4230' Depth of Csg. Cmdt. 4229' Casing { New } Size 4½ Size of Hole 6½
 { xUsed } Weight 9.5 Amount of Cement 70

Kind of Cement Portland

Top Cement 3646' Run No. 1 { Rotary }
 { Cable }

Survey From G.L. Ft. To 4187' Ft. }

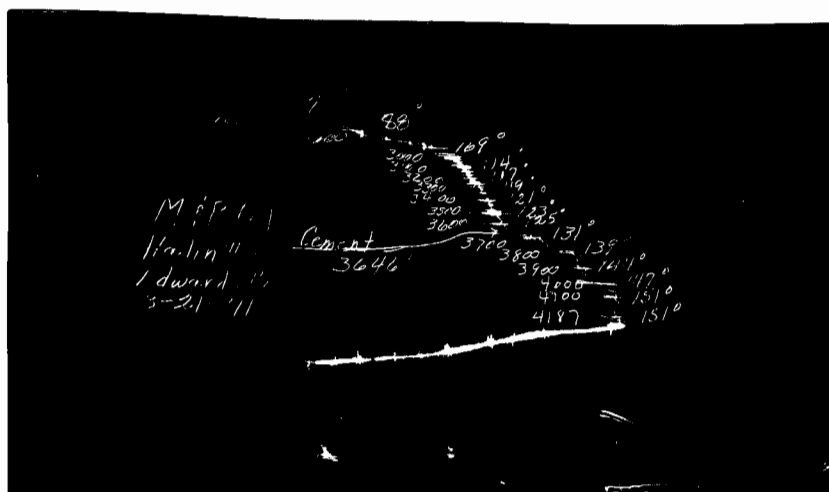

This is an actual photograph of recorder chart.