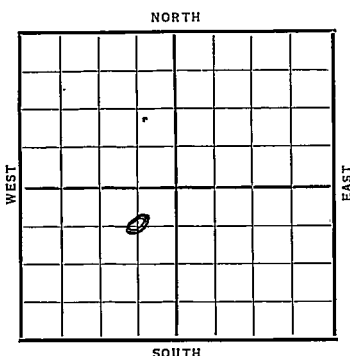


KANSAS

Form 252-A-5M-7-36-Palace

Reno

Sec. 16 Twp. 24 R. 4-WWell No. #1-Collins FarmFalcon Seaboard & Shell Company661 Ft. from N. Line Ft. from S. Line659 Ft. from E. Line Ft. from W. LineDate
1936

REPORT

9/16 R.O.G.

9/24 Rigging up.

10/1 12" @ 320'. WOC.

10/8 Drlg. 2929'.

10/15 Chat 3390'. 7" @ 3419'. T.D.

3424'. Rigging up standard tools

10/22--

10/29 Chat ~~3369'~~ TD. 3374'. 2000
gallons of acid. 488 bbls of
oil and 225 bbls of water. Drlg.
3375'.

11/6 T. D. 2381 4000 acid No Test

11/10 Chat 3369 T. D. 3381

6500 Acid

Pot. 812 Oil, 1500 Water

COMPLETED

Map No. 40 Sec. 16 Twp. 24 R. 4W.Well No. 1 CollinsFalmer Sealed & Shale Company

Contractor

SECTION PLAT

	0		

661 Ft. from N. Line

_____ Ft. from S. Line

659 Ft. from E. Line

_____ Ft. from W. Line

FIRST REPORT

Location _____

Rig up _____

Drilling and Remarks:

RCG

RECORD

Cased _____ in., _____ ft.

Sand _____

Gas _____

Oil _____

Total Depth _____

PRODUCTION

1st 24 hrs. Nat. _____

1st 24 hrs. after shot _____

Gas _____ Cu. Ft.

Dry Hole _____

Abandoned _____

Date

SEP 16 1936 19


S. J. LEWIS Scout

KANSAS

Map No. 40 Sec. 16 Twp. 24 R. 4WWell No. 1 CollinsFalcon & Sea Food & Shell Company

Contractor

SECTION PLAT

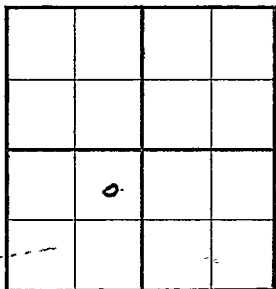661 Ft. from N. Line

_____ Ft. from S. Line

657 Ft. from E. Line

_____ Ft. from W. Line

COMPLETED

RECORD

Location _____

Cased _____ in., _____ ft.

Rig up _____

Sand _____

Drilling and Remarks:

Gas _____

Oil _____

Total Depth 3381

PRODUCTION

1st 24 hrs. Nat. _____

1st 24 hrs. after shot _____

Gas _____ Cu. Ft.

Dry Hole _____

Abandoned _____

Date

NOV 10 1936 19

S. J. LEWIS Scout