

Section 16 Township 24 Range 8W

Well No. #1 Birket

Company Cities Service

NORTH

0							

WEST

EAST

SOUTH

Reno

KANSAS

Sec. 16 Twp. 24 R. 8W

#1 Birket

Well No. _____ Farm _____

Cities Service

Company

Holm Drlg.

Contractor

Wildcat


Ft. from N. Line

330' Ft. from S. Line

Ft. from E. Line

330' Ft. from W. Line

SW SW SW

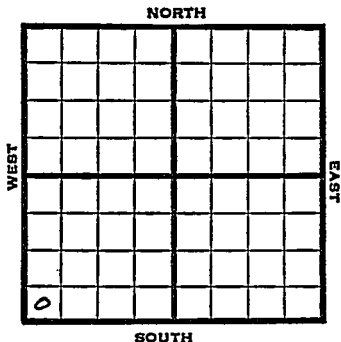

1951

Elev. 1648'

REPORT

6/6

Location

8/8

Spud 6-12-51

Oil well TD 3785' 8" @ 217'

Top. 2606' Lans. 3155'

DST 3367-80 open 1/2 hr. rec 90' HOCM
60' OCM

DST 3414-19 open 1/2 hr. rec 3' mud

DST 3426-33 open 1/2 hr. rec 12' OCM

DST 3482-88 open 1/2 hr. rec 35' OCM

SSO.

Kh. 3634' Viola 3742' Simp. 3779'

TD 3785' 5" @ 3544' CO to 3522'

28/ 3481-91 18/3501-07


FU 160' oil P/2 BO 1 BW 4 hr.

48/3423-35 2000 A 5000 A

P/ 38 BO 9 BW

Comp. 39 BOPD 2 BW

COMPLETED

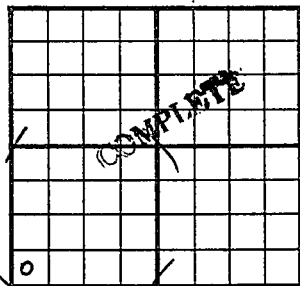County Reno State KansasSec. 16 (Blk.
Twp.) 24 (Sur.
Rge.) 8W Map No.Operator Cities ServiceWell No. 1 Farm BirketElev. 1648 Location SW SW SW330 Ft. From S Line SW330 Ft. From W Line Quarter

Ist. Report

Completion AUG 8 1951Remarks WildcatHolm Drlg. - Contr.Spudding Date 6-12-51Drlg. Data Oil well TD 37858" @ 217 Top. 2606 Lans. 3155DST 3367-80 open $\frac{1}{2}$ hr. Rec. 90' hocom60' ocm DST 3414-19 open $\frac{1}{2}$ hr.Rec. 3' mud DST 3426-33 open $\frac{1}{2}$ hr.Rec. 12' ocm DST 3482-88 open $\frac{1}{2}$ hr.Rec. 35' ocm SSO KH. 3634 Viola 3742Simp. 3779 TD 3785 5" @ 3544CO to 3522 28/ 3481-91 18/ 3501-07FU 160' oil P/ 2 bo 1 bw 4 hr.48/ 3423-35 2000 A 5000 A P/ 38 bo9 bw Comp. 39 bopd 2 bw

J. E. TYRA