

Section 16 Township 24 Range 12 W

Well No. # 1 Gallaway

Company Anschutz Drilg.

NORTH

0							

WEST

EAST

SOUTH

Stafford

KANSAS

Sec. 16 Twp. 24 R. 12W

Well No. #1 Gallaway Farm

Anschutz Drlg. _____ Company

Wildcat

Ft. from N. Line


330 Ft. from S. Line

Ft. from E. Line

330 Ft. from W. Line

SW SW NW

Sinclair DHM

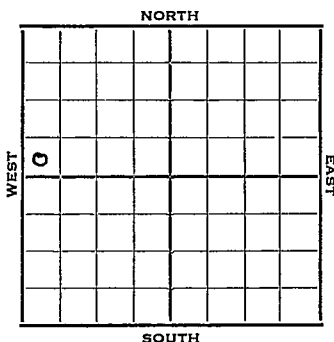

1952	Elev. 1883'	REPORT
------	-------------	--------

7/30	Cellar & pits
------	---------------

8/6 | 8" @ 268 Anhy 690 Drlg. 900


8/13	Heeb. 3320	Br Li 3474
	Lans. 3501	

DST 3505-50, 1 hr. 30' CSOCM 1.
140# Drlg. 3655' 1

8/20 Spud 8-2-52
D&A TD 4080
8" @ 268 Anhy 690
Heeb. 3320 Br Lime 3474
Lans. 3501
DST 3505-50 opn 1 hr. Rec. 30'
vsocm 140# DST 3626-56
opn 1 hr. Rec. 90' socm 30' w & m
580# Cong. 3827 Viola 3887
DST 3903-10 opn $\frac{1}{2}$ hr. Rec. 6' mud
O# Arb. 4065 TD 4080
D&A **ABANDONED**

J. G. McGEHEE

County Stafford State Kansas
 Sec. 16 (Blk. 24 (Sur. 12W Map No.
 Operator Anschutz Drlg.
 Well No. 1 Farm Gallaway
 Elev. 1883 Location SW SW NW

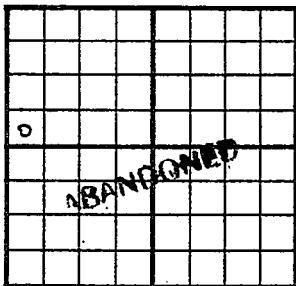

330 Ft. From S Line NW

330 Ft. From W Line Quarter

1st. Report

Completion AUG 20 1952

Remarks Wildcat

Spudding Date 8-2-52

Drlg. Data D & A TD 4080

8" @ 268 Anhy 690 Heeb. 3320

Br. lime 3474 Lans. 3501 DST 3505-50

open 1 hr. Rec. 30' vsocm 140#

DST 3626-56 open 1 hr. Rec. 90' socm

30' w & m 580# Cong. 3827 Viola 3887

DST 3903-10 open 1 hr. Rec. 6' mud 0#

Arb. 4065 TD 4080

D & A

J. G. McGEHEE