

Section 16 Township 24 Range 13-W

Well No. 1 Curtis

Company Virginia Drlg.

Van Liew Pool

NORTH

0							

WEST

EAST

SOUTH

Sec. 16 Twp. 24 R. 13W

Well No. #1 Curtis Farm

Virginia Company


330 Ft. from N. Line

 Ft. from S. Line

 Ft. from E. Line

330 Ft. from W. Line

NW/4

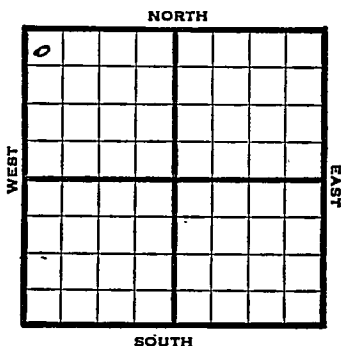

1947

Elev. 1921 REPORT

10/1

8" @ 256'
Anhy. 786'
Drlg. 1350'

10/8

Drlg. 3248'

10/15

Lansing 3562
Viola 3937
Simpson 4041
Abbuckle 4098
TD 4148

ABANDONED

Map No. _____ Sec. 16 Twp. 24 R. 13W

Well No. 1 Curtis

Virginia Drlg. Company

FIRST REPORT Contractor

NT/C


SECTION PLAT

330 Ft. from N. Line

_____ Ft. from S. Line

_____ Ft. from E. Line

330 Ft. from W. Line

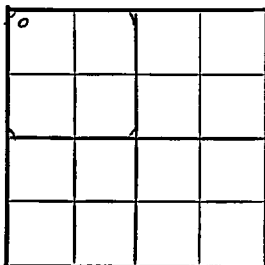

Stafford County

Location _____

Rig up _____

Drilling and Remarks:

8" @ 256

dnhy 786

drlg. 1350

RECORD

Cased _____ in., _____ ft.

Sand _____

Gas _____

Oil _____

Total Depth _____

PRODUCTION

1st 24 hrs. Nat. _____

1st 24 hrs. after shot _____

Gas _____ Cu. Ft.

Dry Hole _____

Abandoned _____

Date

OCT 1 1947 19

S. J. LEWIS Scout

Map No. 93 Sec. 16 Twp. 24 R. 13W

Well No. 1 Curtis

Virginia Drlg. Company

ABANDONED

Contractor

NW/C

E. 1921
SECTION PLAT

330 Ft. from N. Line

_____ Ft. from S. Line

_____ Ft. from E. Line

330 Ft. from W. Line

4			

Stafford County

Location _____

Rig up _____

Drilling and Remarks:


RECORD

Cased _____ in., _____ ft.

Sand _____

Gas _____

Oil _____

Total Depth 4148

PRODUCTION

1st 24 hrs. Nat. _____

1st 24 hrs. after shot _____

Gas _____ Cu. Ft.

Dry Hole _____

Abandoned _____

Date

OCT 15 1947 19

S. J. LEWIS Scout