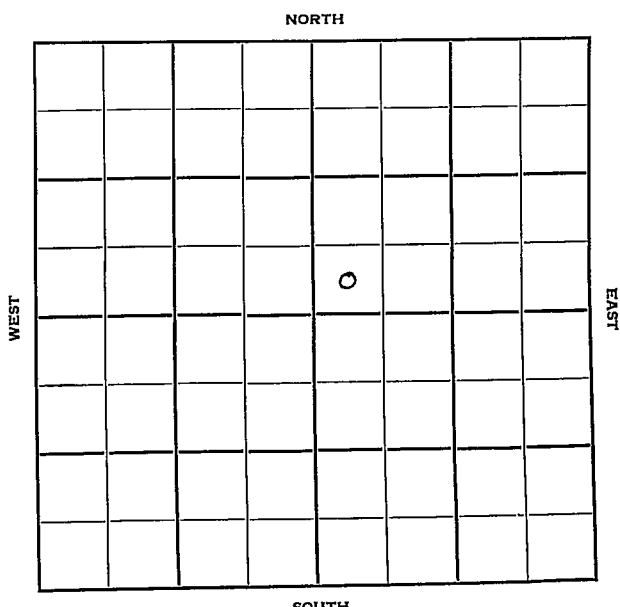


Section 16 Township 24 Range 13-WWell No. #1 DelpCompany Mallard Drlg.

Stafford KANSAS

Sec. 16 Twp. 24 R. 13W

Well No. #1 Delp Farm

Mallard Drlg. Company

Mallard Drlg. Contractor

Wildcat


 Ft. from N. Line

330' Ft. from S. Line

 Ft. from E. Line

330' Ft. from W. Line

SW SW NE

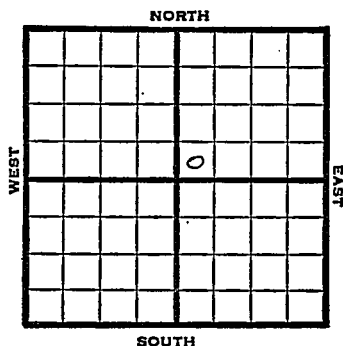

1950

Elev. 1921' REPORT

6/21

Spud 6-19-50

7/5

8" @ 312'

Lans. 3555'

Cong. 3913'

Viola 3936'

Simp 4065' -

Arb. 4119'

TD 4160'

D&A

ABANDONED

Kansas

Map No. _____ Sec. 16 Twp. 24 R. 13WWell No. 1 Delp

_____ Mallard Drlg. _____ Company

_____ Mallard Drlg. _____ Contractor

SW SW NE


_____ Ft. from N. Line

330 Ft. from S. Line

_____ Ft. from E. Line

330 Ft. from W. Line

SECTION PLAT

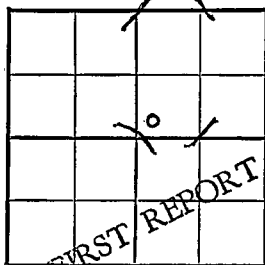

Stafford County

Location _____

Rig up _____

Drilling and Remarks:

Spud 6-19-50

RECORD

Cased _____ in., _____ ft.

Sand _____

Gas _____

Oil _____

Total Depth _____

PRODUCTION

1st 24 hrs. Nat. _____

1st 24 hrs. after shot _____

Gas _____ Cu. Ft.

Dry Hole _____

Abandoned _____

Date

JUN 21 1950 19J. E. TYRA Scout

~~Kansas~~Map No. _____ Sec. 16 Twp. 24 R. 13WWell No. 1 Delp

_____ Mallard Drlg. _____ Company

_____ Contractor


SW ST NE

El. 1921
SECTION PLAT

_____ Ft. from N. Line

330 Ft. from S. Line

_____ Ft. from E. Line

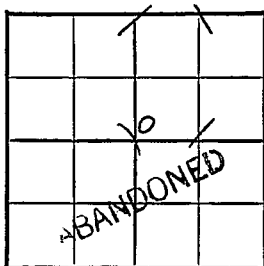330 Ft. from W. Line

Stafford County

Location _____

Rig up _____

Drilling and Remarks:

8" C 312

Lans. 3555

Cong. 3913

Viola 3936

Simp. 4065

Arb. 4119

RECORD

Cased _____ in., _____ ft.

Sand _____

Gas _____

Oil _____

Total Depth 4160

PRODUCTION

1st 24 hrs. Nat. _____

1st 24 hrs. after shot _____

Gas _____ Cu. Ft.

Dry Hole _____

Abandoned _____

TD 4160

Date D & AJUL 5 1950 19 F TYRA Scout