

Stafford


KANSAS

SECTION 16 TOWNSHIP 24 RANGE 14W

WELL NO. #1 Smith

COMPANY D.R. Lauck & Sunray Mid-Continent

NORTH

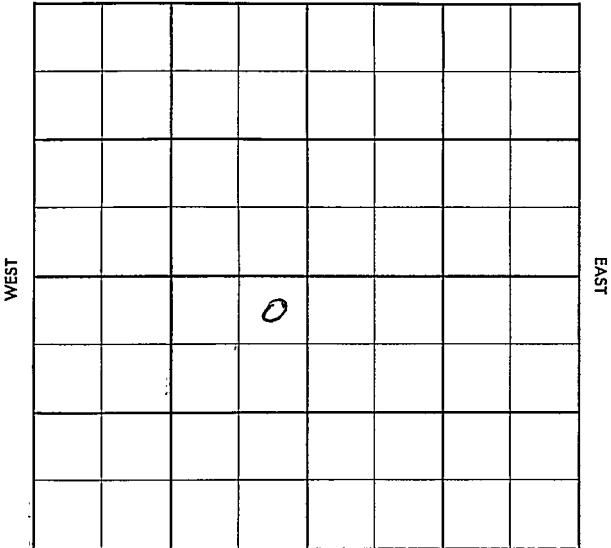

SOUTH

HOT FILE Stafford KANSAS

SEC.	TWP.	R.
16	24	14 W

WELL NO.

4 Smith

FARM

COMPANY

Lauck & SDX (DEVELOPMENT-OB0C)

CONTRACTOR

Co. tools

~~Rattlesnake Field~~


Dillwin

Ft. from N. Line

Ft. from S. Line

Ft. from E. Line

Ft. from W. Line

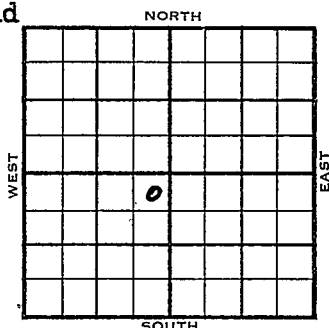

NE NE SW

(50' SW of dry hole)

ELEVATION

REPORT

1956 1976' DF 1978' KB 1973' GL

4300' Arbuckle

4/23 Spudded 4-21-56 8" @212/165 (FR Tkt)
TD 212'. WOC - surface csg. (DR#79)

4/24 TD 212' WOC - surface csg.

4/25 Drlg. 1285'

4/25 Drlg. 1900' (Card-Lauck Oil)

4/27 Drlg. 2160'

4/30 TD 2160' No report.

5/1 Drlg. 3415'

5/2 Drlg. 3675'

5/3 Drlg. 3815'

5/4 Drlg. 3930'

5/7 ~~Drilg~~ TD 4294'. Prep to DST.

5/8 TD 4294'. WOC - 5 1/2" @ 4291'

5/9 TD 4297'. WOC - 5 1/2" csg.

5/10 TD 4297' No report.

5/11 " "

5/14 TD 4297'. Swabbed @ 480 bbls oil day
rate. Open hole 4291-4297'. Arbuckle
Zone. COMPLETE (DR#94)5/18 Received copies of Driller's Log,
Laterolog Survey & Sample analysis
report. Given to S.A. Shannon, Div.
Geologist, Wichita District.

OVER

1956

5-29 Comm. 4-21-56

8" @ 212 w/165

DST 3800-15 op 1 hr. rec. 45' mud,
FP 0#, BHP 115/20".

DST 4070-98 op 1 hr. rec. 185' thin
O&GCM, FP 0-50, BHP 440 (increase 30min)

DST 4294-98 op 1 hr. ~~xxx~~ 1690' gas, rec
1470' gassy oil, FP 0-460#, BHP 1030/
40"

RTD 4298'

Ran Log.

5 $\frac{1}{2}$ " @ 4291

CO 4298

S/ 20 boph, no/wtr., 7 hrs.

S/ 600' O.B.

P/ 402 BOPD, no wtr.,

Grav. est. 35.

Anh. 915', H. 3520', BL. 3664', L. 3684

BKC 4025', M. 4069', V. 4157',

S. Sh. 4232', A. 4290'.

Log Tops: H. 3519', BL. 3662', L. 3682',

BKC 3943', M. 4068', V. 4157',

S. Sh. 4232', A. 4290'.

TD 4298'

COMPLETED

County Stafford Elev. _____
 Sec. 16 Twp. R 10 N Rge. 11W
 Company D.R. Lauck & Sunray Mid-Continent
 Farm Name Smith No. 4

TOPS	DEPTH	LOG	DATUM	Loc. in Sec.
Anb.				NE NE SW
TP.				50' SW of
H.				dry hole
Tr.				
Dg.				
Bl.				
L.				Geol.
K.C.				Contr.
B.K.C.				Co. tools
Ce.				Pool LAUCK
C.				D. Irwin
M.				
M.				
K.				
Mz.				
Mo.				
V.				
S.				
S.				
A.				
R.				
PE.				
G.				
TD.				

FIRST REPORT

APR 25 '56

Date Comm. 4-21-56
8" @ 212/165 WOC

No Township *25*

Co.

County Stafford Elev. 1976
 Sec. 16 Twp. 21 Rge. 14W
 Company D.R. Lauck & Sunray Mid-Continent
 Farm Name Smith No. 11

TOPS	DEPTH	LOG	DATUM	Loc. in Sec.
Anh.	915			NE NE SW
Tr.				
H.	3520	3519		50' SW of
Tr.				dry hole
Dg.				
BL.	3664	3662		
L.	3684	3682	1726	Geol.
K.C.				
BKC.	4025	3943	1967	Contr.
Ce.				
C.				Co. tools
M.	4069	4068	2092	
M.				Pool
K.				Dillwin
Mz.				
Ma.				
V.	4157	4157	2181	COMPLETE
S.	4232	4232	2255	
S.				
A.	4290	4290	2314	
R.				
PE.				
G.				
TD.	4298			

Loc.

No.

Sec.

T.

R.

Date Comm. 4-21-56 MAY 29 1956

8" @ 212/165 WOC MAY 2 '56 Anh 915

MAY 9 '56 Hb 3520 BL 3664

Lsg 3684 DST 3800-15 ap 1 hr² rec.
 45' Md FPO BHP 115/20" BKC 4025
 Miss 4069 DST 4070-98 1 hr rec. 185'
 Thin O&GCM FPO-50 BHP 440 (increas
 30' Viola 4157 spsh 4232 ARB 4290
 DST 4294-98 1 hr 1690 gas rec
 1470' gssy oil FPO-460 BHP 1030/40"

RTD 4298 Ran Log 5 1/2 @ 4291
Log Tops MAY 16 '56 CO. 4298 TD \$
20 Bopb no/w 7 hrs. \$ 600' O.B.
T&R MAY 23 '56 Pumping no +st.
MAY 23 '56 Ph P. 402 Bopd no/w to
gravel est 35° Arb O.H 4291
- 4298 TD.