

Stafford


KANSAS

SECTION 16 TOWNSHIP 24 RANGE 11 W

WELL NO. #1 Thuro Smith

COMPANY D.F. Lauck & Sunray Mid-Continent

NORTH

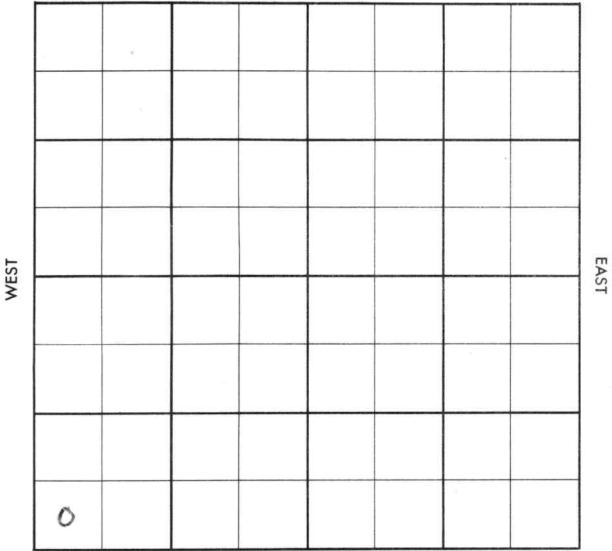

SOUTH

SEC. 16 TWP. 24 S R. 14 W

WELL NO. # 1 ~~Thurrow~~ (Smith) FARM

COMPANY D. R. Lauck & Sunray Mid-Continent

CONTRACTOR Lauck (~~DEVELOPMENT-OBOS~~)

Wildcat  
 \_\_\_\_\_ Ft. from N. Line  
 \_\_\_\_\_ Ft. from S. Line  
 \_\_\_\_\_ Ft. from E. Line  
 \_\_\_\_\_ Ft. from W. Line



SW SW SW  
 SDX - FO  
 Nat'l. Coop. Refg. Assoc. - \$2500.00 DHC

1955 ELEVATION 1976' DF 1978' KB REPORT (WH5-F014)

- 11/11 Arbuckle Dolomite Test Well 5-27048  
 To be commenced by Dec. 20, 1955  
 To be completed by Feb. 5, 1956  
 (See DHC Ltr. 11-10-55)
- 11/30 Location (F.R. Ticket)
- 12/2 Spud 12-1-55  
 Set 8-5/8" @ 200'  
 WOC TD 200' (Card-D.R.Lauck)
- 12/3 Drlg. 1430' "
- 12/4 Drlg. 2060' "
- 12/6 Drlg. 2780' "
- 12/7 Drlg. 3215' "
- 12/8 Drlg. 3500' "
- 12/9 Drlg. 3680' "
- 12/10 Drlg. 3810' "
- 12/11 Drlg. 3905' "
- T. Anhydrite 865' (by driller)
- T. Heebner 3513' (Sample)
- ~~TXXX~~ T. Br. lime 3658' "
- T. Lans.-KC 3677' "
- No shows of any consequence. "
- 12/12 Drlg. 4047'.  
 B. KC 3947' (-1969) no shows. "
- 12/13 Drlg. 4130' "

1955

12/14

Drlg. 4222'.

Top Viola 4135' (-2157)

No shows. (Card-D.R. Lauck Oil Co

12/17

5 $\frac{1}{2}$ " @ 4294 TD 4301'

DST 4295-4301, rec 1860' oil, BHP 1310

(Card-Lauck Oil

12/27

TD 4301'. Open hole 4294-4301',

Arbuckle Zone, Swabbed 912 BO/

day rate - Completed 12-21-55 (DR#252

12/29

Received Halliburton Elec. Survey

Log from D.R. Lauck Oil.

1/3/56

Advised Contract Section - Complete

1-19

Waiting on state test

1-26

No report

2-2-

"

2-8

Waiting on potential

County Stafford Elev. \_\_\_\_\_  
 Sec. 16 Twp. 24 Rge. 14W  
 Company D.R. Lauck & Sunray Mid-Continent  
 Farm Name Thurrow No. 1

TOPS	DEPTH	LOG	DATUM
Anh.			
Tp.			
H.			
Tr.			
Dg.			
B.L.			
L.			
K.C.			
B.K.C.			
Ce.			
C.			
M.			
M.			
K.			
Mz.			
Me.			
V.			
S.			
S.			
A			
R.			
PE.			
G.			
T.D.			

Loc. in Sec. SW SW SW

Geol. \_\_\_\_\_  
 Contr. Lauck

Pool Wildcat

FIRST REPORT  
 NOV 30 1955

Date Comm. \_\_\_\_\_  
 Location \_\_\_\_\_

Co.  
 Lsc.  
 No.  
 Sec.  
 T.  
 R.

*[Handwritten signature]*

360  
16  
1701

County Stafford Elev. 1976  
 Sec. 16 Twp. 2N Rge. 11W  
 Company D.R. Lanck & Sunray Mid-Continent  
 Farm Name TAMMOW Smith No. 1

TOPS	DEPTH	LOG	DATUM	Loc. in Sec.
Ant.				SW SW SW
Tp.				
H.	3513	3514		
Tc.		3532		
Sp.		3554	1578	
D1.	3682	3659	1683	
L.				P. Clark
Kc.	3677	3678	1702	Geol.
D1c.	3947	3933	1927	Conts.
Co.				Lanck
C.				Dillwyn Pool
M.				Pool
N.				Wildcat
Mo.				
Me.				
V.	4295	4130	2154	COMPLETE
S. sd	4237	4235	2259	
S. sd	4251	4253	2279	
A.	4295	4295	2319	
R.				
PC.				
G.				
20	4301			0

Date Comm.

FEB 15 1956

Location DEC 7 '55 Spd 12-1-55  
 RTP 200/175  $\phi$  2315 DEC 14 '55  
 $\phi$  4130 DEC 21 '55 DST 4295-4301  
 op 160 960' gas Rec 1860 oil  
 FP 100-740 BMP 1310/20" RTP  
 4301  $\phi$  Log 5 1/2 @ 4294/250  
 MIST CO 4301 TD FU 2500'  
 oil 3 hrs & down and  $\phi$  40  
 Bath. Rel. data 3 hrs T & R

DEC 28 '55 POP P. 172 Bo nolw

24 hrs wa st Pot. JAN 5 '56

JAN 11 '56

JAN 18 '56

wa st Pot. JAN 25 '56

FEB 1 '56

Lag Topa

FEB 8 '56

wa

Pot FEB 15 '56

Ph P 265

Bopd nolw

gran 31°

R.G.

FEB 27 1956