

Stafford

KANSAS

SECTION 16 TOWNSHIP 24 RANGE 14W

WELL NO. #9 ~~SWD~~ Smith

COMPANY D.R. Lauck

NORTH				SW SW SW			
0							
SOUTH							

WEST EAST

HOT FILE Stafford KANSAS

SEC.

16

TWP.

24 S

R.

14 W

WELL NO.

9-SWD J. T. Smith

FARM

COMPANY

D. R. Lauck (DEVELOPMENT-OB^{OC})

CONTRACTOR

Dillwin Field.


_____ FT. FROM N. LINE

~~180~~ ²⁰⁰ _____ FT. FROM S. LINE

_____ FT. FROM E. LINE

~~330~~ ⁵⁰⁰ _____ FT. FROM W. LINE
of Sec.

SW SW SW

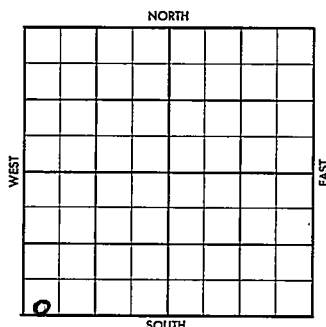

ELEVATION

REPORT

1957

10/2	4400' Arbuckle Test RURT	(FR Tkt)
10/14	Spudded 10-4-57 Drlg. 3655'	(DR#200)
10/15	Drlg. 4154'	
10/16	TD 4154' NR	
10/17	Drlg. 4344'	
10/18	TD 4440' . Rng. EL	
10/21	TD 4440' . NR	
10/22	" "	
10/23	" "	
10/24	" "	
10/25	" "	
10/28	" "	
10/29	TD 4440' . SWD Well Open hole 4370- 4440' Arbuckle Zone. Complete	(DR#211)

S-513-A

CO. Stafford ELEV.

SEC. 16 TWP. 24 RGE. 1E

COMPANY D.R. Lauck NO. 9

REPORT	OCT 2 1937
--------	------------

FARM Smith

SWD

LOC. SW SW SW 200' SL 500' WL

CO. _____

LOC. _____

GEOL. _____

CONTR. _____

POOL Dillwin

SPUD _____

REPORT

NO. _____

SEC. _____

TWP. _____

RGE. _____

1A5 1A7

100' 110'

Dillwin

ABANDONED

CO. Stafford

ELEV. 1978 KB

SEC. 16

TWP. 24

RGE. 14W

COMPANY D.R. Lauck

NO. 9-SWD

OCT 23 57

200' SL 500 WL

FARM Smith

LOC. SW SW SW

Log TOPS

~~A 910~~

H 3513

TR 3535

D9 3552

BI 3657

Lsg 3777

BKC 3940

U 4125

S 4234

A 4298

GEOL.

breaks out

CONTR.

Lauck Dr. 1st

POOL

Dillwin

SPUD

10-1-57

RURT

100' 9" Tops

104200/165

#2790

~~#2790~~

#4220

X Log TOPS

7" 4320-742

LTD 4339

RTD 4440

CO 4440

Disposal in Arbockle

Winded in 2' 10" E

TO BE SWDW