


SEC. 16 TWP. 24 S R. 14 W

WELL NO. # 6 Smith FARM

COMPANY D.R. Lauck Oil Co. (DEVELOPMENT*OBOC)
 CONTRACTOR & SDX

Dillwin Field

_____ FT. FROM N. LINE
 990 _____ FT. FROM S. LINE
 330 _____ FT. FROM E. LINE
 _____ FT. FROM W. LINE
 of SW/4
 NE SE SW

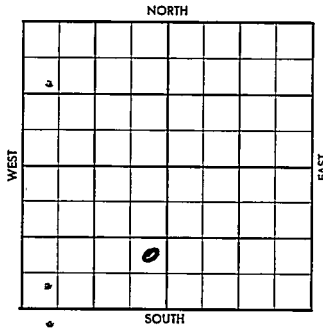

1956 ELEVATION 1980' DF 1982' REPORT 1978' Gr.

- 4300' Arbuckle Test
- 9/15 Spudded 9-15-56 (FR Tkt)
 Set 8-5/8" @ 295 w/165 sks.
 (Card-DR Lauck)
- 9/17 Drlg. 1405' (DR#182)
- 9/18 Drlg. 2060' (Card-D.R. Lauck)
- 9/19 Drlg. 2400' "
- 9/20 Drlg. 2400' "
- 9/20 Drlg. 2760' "
- 9/21 Drlg. 3115' "
- 9/22 Drlg. 3460' "
- 9/23 Drlg. 3700' "
- 9/24 Drlg. 3815'
 DST #1 (M-D) 3799-3813, open 1 hr,
 fair blow, 28 min, died. rec 30' mud
 w/specks oil. All pressures Off.
 Anhy 915', Heebner 3519', Brown lime
 3660', Lansing 3680' (Card-DR Lauck)
- 9/25 Drlg. 3990' "
 Base KC 3943'
- 9/26 Drlg. 4115' "
- ~~9/27 Drlg.~~
- 9/27 Drlg. 4210' "

OVER

1956
9/28

Drlg. 4295' RTD
Viola 4140'
Simpson 4232
Arbuckle 4291
RTD 4295'

Halliburton Guard Log tops:
Heeb 3519', Bn Ls 3660', L, KC 3680',
BKC 3943', Cgl 4058', Viola 4122',
Sp Sh 4234', Arb. 4292',
TD 4295'. 5 $\frac{1}{2}$ " @ 4293'

(Card-DR Lauck)

~~10/1 TD 4295' NR~~

10/1 TD 4295' No Report

10/2 " "

10/3 " "

10/4 TD 4295'. Testing.

10/5 TD 4296'. Testing open hole 4293-4296'
5 $\frac{1}{2}$ " @ 4293'

10/8 TD 4296'. Swabbed 120 BO 24 hrs.

Open hole 4293-4296'. Arbuckle
Zone. Complete (DR#196)

10/10 Received copy of Geological report,
Driller's Log, and Halliburton
Radiation Guard Log. - Given to
S.A. Shannon, Wichita District,
Div. Geologist.

County Stafford Elev. _____
 Sec. 16 Twp. 24 Rge. 14W
 Company D.R. Lauck & Sunray Mid-Continent
 Farm Name Smith No. 6

TOPS	DEPTH	LOG	DATUM	Loc. in Sec.
Anh.	915			NE SW SW
Tr.				
Dg.				
Bl.				
L.				Geol.
K.C.				Contr.
B.K.C.				D.R. Lauck
Ce.				Tools
C.				Pool
M.				Dillwin
Mz.				
Me.				
V.				
S.				
S.				FIRST REPORT
A				SEP 19 '56
R.				
Pe.				
G.				
T.D.				

Date Comm. 9-15-56
 8" @ 205 w/165, Drlg. 1405 SEP 26 '56

W.M

Loc. No. 16 24 14W
 County Stafford Elev. 1980
 Sec. 16 Twp. 24 Rge. 14W
 Company D.R. Lauck & Sunray Mid-Continent
 Farm Name Smith No. 6

TOPS	DEPTH	LOG	DATUM	Loc. in Sec.
Anb.	915			NE SE SW
TP.				
H.	3519			
Tr.				
Dg.				
Bl.	3660			
L.	3680			
K.C.				Geol.
B.K.C.				Contr.
Ce.				D.R. Lauck
C.				Tools
M.				Pool
M.				Dillwin
K.				
Mz.				
Mo.				
V.	4140			OCT 24 '56
S.	4232			COMPLETE
S.				
A.	4291			
R.				
PE.				
G.				
TD.	4295			

Date Comm. 9-15-56
8" @ 205 w/165, Drlg. 1405 SEP 20 '56' H6
3519 BL 3660 L59 3680 DST
3799-3813 sp 1hr rec. 30' Salty
Md (specks oil) All press o 11" 195"
OCT 3 '55 X ~~4140~~ ~~4232~~ ~~4291~~
~~4291~~ V10 4140 SP 4232 H16 4291
RTD 4295 5 1/2 @ 4293 MICT
CO OCT 10 '56 X ~~4295~~ ~~4297~~ - ~~SP~~
CO DD 4297 TD FU 700' oil

no wtr 15" FU 3000 oil nolw
3 hrs \$ 125 BO no wtr in
5 hrs T&R OCT 17 '56 X POP
DC. 2. 56 Ph P 356 Bopd
no wtr.

16-24-14

re se sw